


24th Street


Quincy Ave.

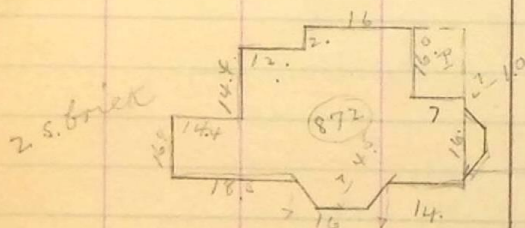

2 s. brick


97.0

1 story frame

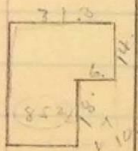

68.0

1 s. brick

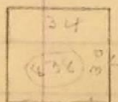

73.0

Back from
center of street

Station

13677

13525

13380