

Apr 14th 92

Station

Upper
Time Chart

136750


73.2

13515

1315

133480

932

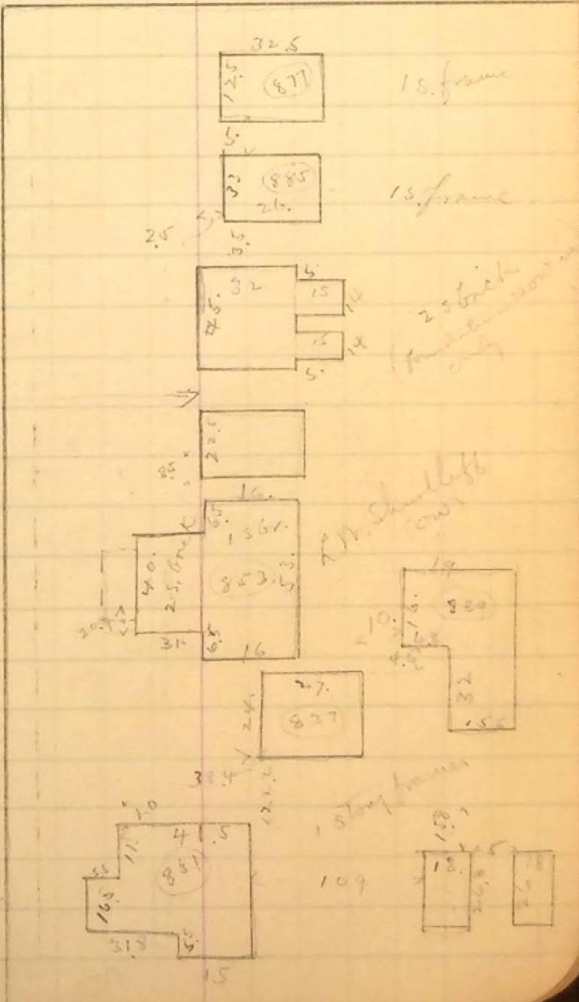

15. frame

15. frame

25. frame

21. Shulliff

109

13 18

13 15