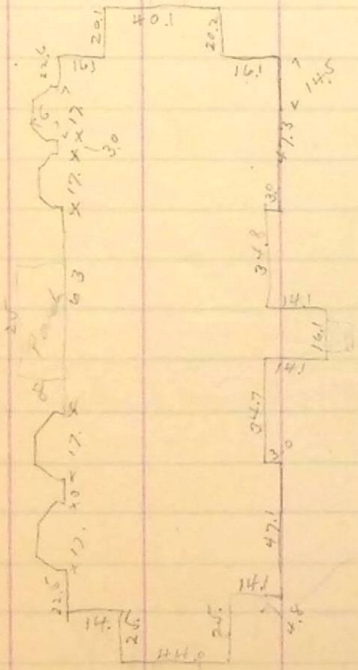25th Street – Bottom Quincy
Location of Building