


Monument at  
Ave -

91

April 1892

East  
↑

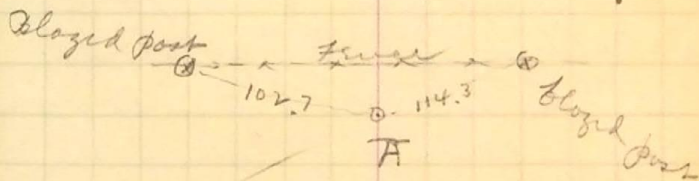

○ Blue Remond Sluffs

dark green frame  
1.0  
Hole on 28th St

East  
↑  
8' →  
B

trails  
line runs  
down approximately  
S. line of 29th