

○ Ben Howard
staff

Eye staff
○


North
↑



Mark edge
of window sill
Numbers of small
16 brick horse
on 25th Street



S.E. corner
of Stone Staff
probably between
24th + 25th St

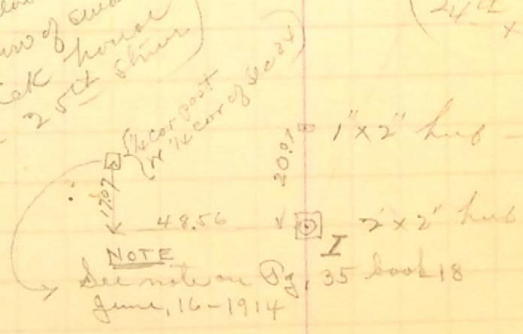

