


North
↑

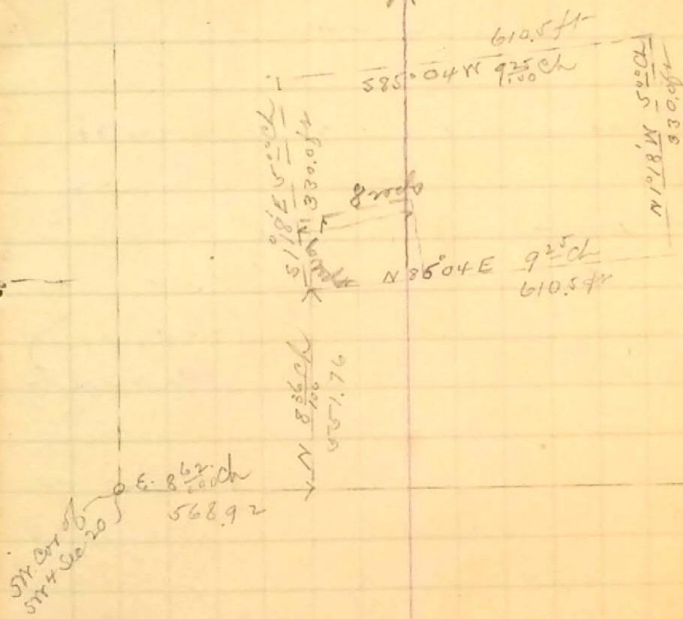

29.4 E
33.4 S