


of School Lot on
Sts - and also locating

107

on p 61 - L. No 9 - north

center 22^e

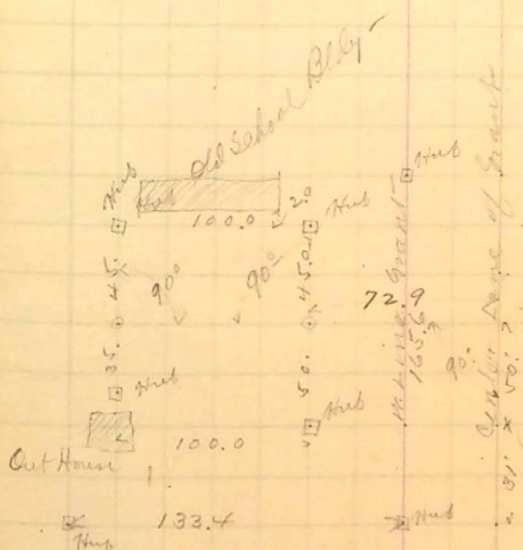

center 23^e St