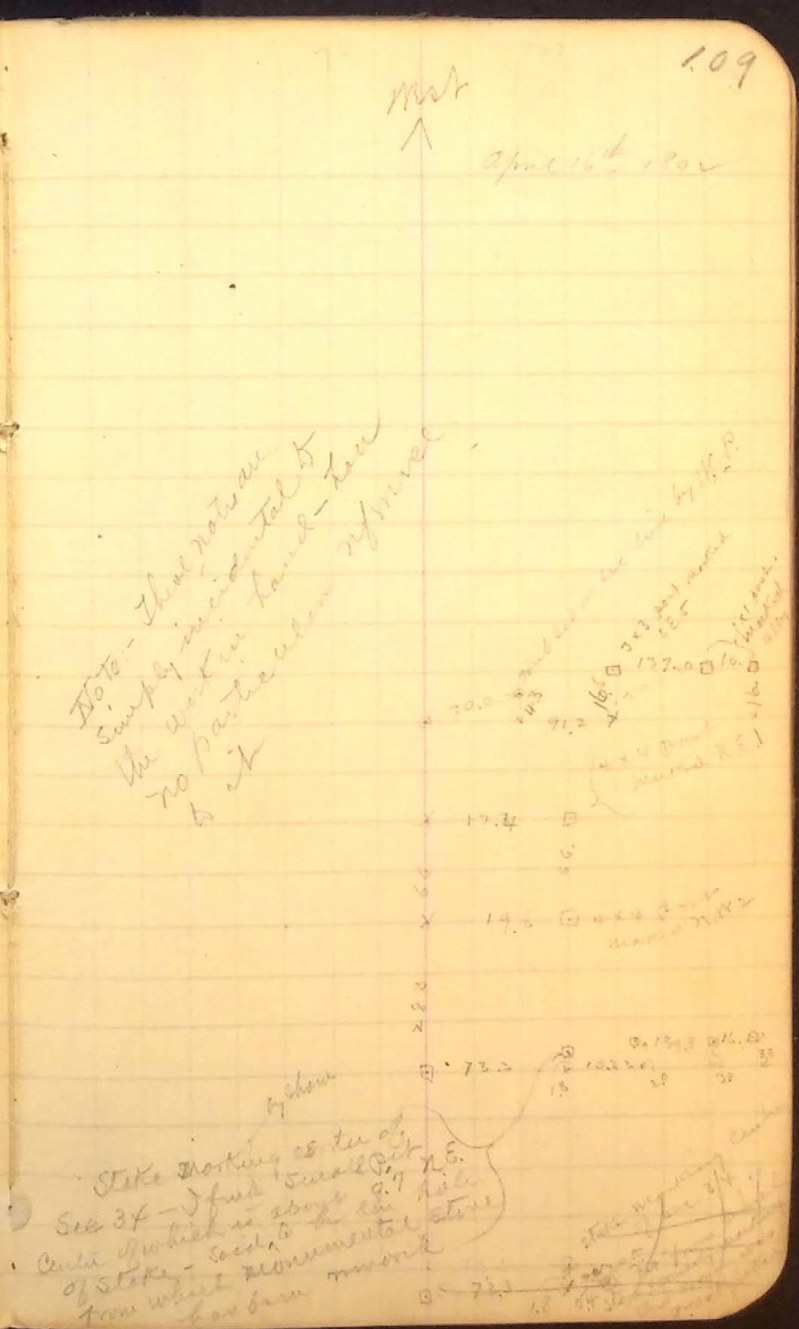
West
April 16th 1902
Note- These notes are simply incidental to the work in hand - for particulars refer to
by chain
Stake marking center of Sec 34 - found small pit Cedar Post in which is stake of Stake - Sec 3 bears 9.7 N.E. from which monument bears
Stake
Sec 34