
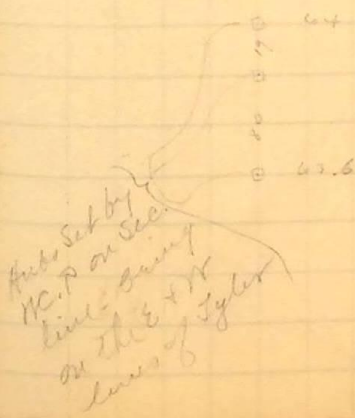


East  
↑

///

transverse 667's South  
cut -

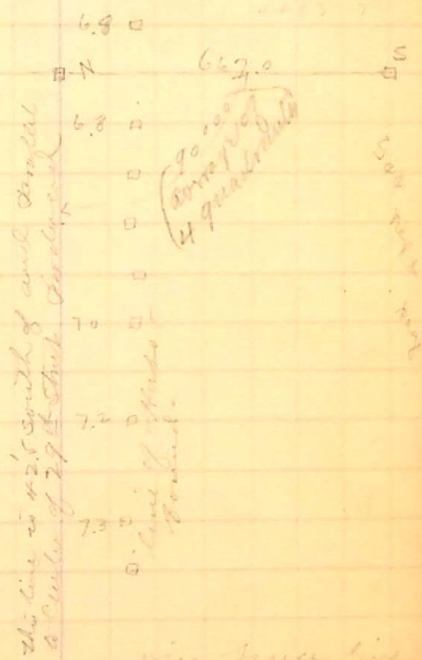

7.5 50 20 40 60