



Intersection of Harrison with

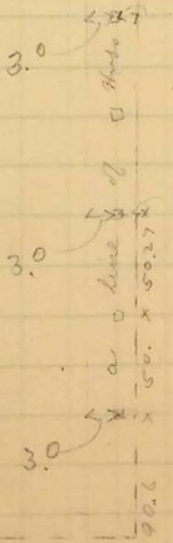

CENTER LINE OF HARRISON

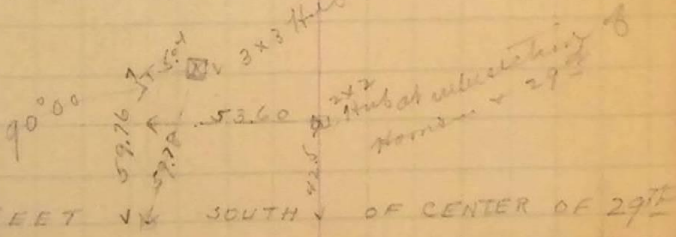

FEET SOUTH OF CENTER OF 29th