Survey & Check University Park Addition - with a view to City's acceptance -

Having set up sight on hub on line 42.5 south of Center of 29th Street - near Wisconsin of Sec 34 - (This line having been established previously) - I set transit on hub on same 42.5 offset near Center - position of said point being shown by sketch as follows =

From Hub "A" I measure West on offset line as follows: - with 200 foot tape L. -

Distance	Slope	Temperature	Catenary	Total Cor.	Correct Dist.
200	3°15	76	100 / 100	-.32 / +.01 / -.02 -.33	199.67
200	3°38	80	—	-.40 / +.02 -.38	199.62
200	2°20	82	—	-.16 / +.02 -.14	199.86
100	2°52	82	—	-.12 / +.01 -.11	99.89
15.25	0°00	—	—		15.25
					714.29

This latter point is the hub set in Survey of Addition - on E. line of same at intersection of 42.5 offset - = Hub "B"
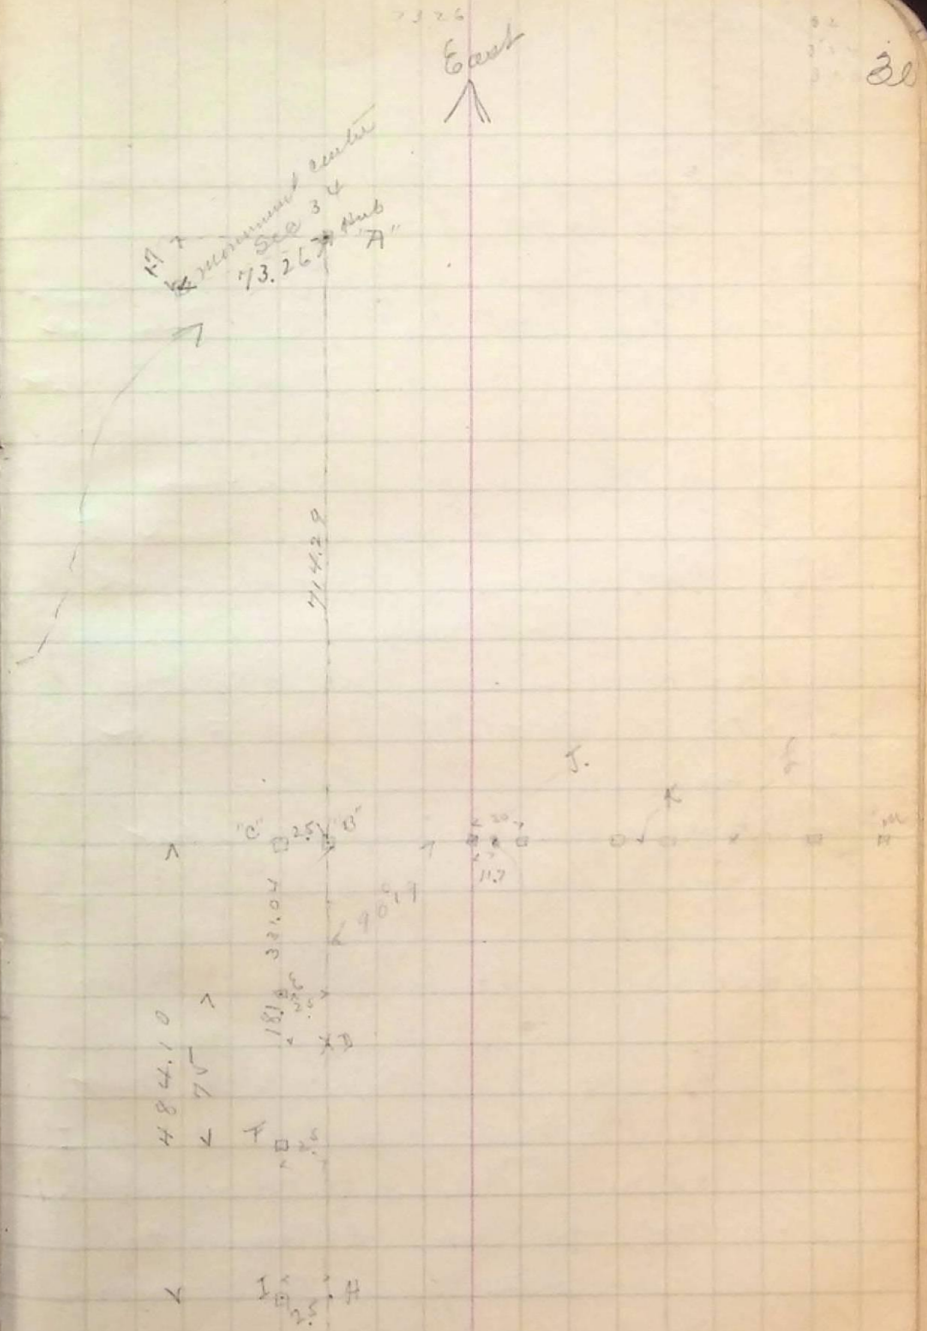
I find Hub C - Marking N.E. Cor of tract 2.5 North of this hub - and ~~at~~ 0.6 E. of Wisconsin running N & S.