

Survey & check distance from
Washington Air To SW corner
of SE 1/4 Sec 32 - 6th 11th

Iron nail at point 10 feet West and 2 feet

South of County Monument B -


between 32^d + 33^d range $\approx 90^{\circ} 16'$ (corner of 4 angles)
from Washington Air and run as
follows

200' tape - 68^o standard - 16th bar

Measure	Slope	Temp.	Corner	Correction		
200	-0°37	98°	$\pm .012$	$\pm .029$	200.029	
200	-0°04	92	$+.033$	$+.033$	200.034	
200	-0°13	99	$-.002$	$+.040$	200.040	
200	0°00	88 [✓]	$+.027$	$+.027$	200.027	
200	+0°18	98	$-.002$	$+.039$	200.039	
200	-0°40	102	$-.014$	$+.032$	200.032	
200	-0°25	98	$-.006$	$+.035$	200.035	
200	-0°30	93	$-.008$	$+.026$	200.026	
100' } Cape }	142	0°00	78	$+.029$	$+.029$	142.029
100'	4°10	88 [✓]	$-.260$	$+.014$	$-.256$	99.924
1842.18					1842.215	
				$+.290$		
				$-.256$		
				$+.034$		

361 00
KV

West
↑

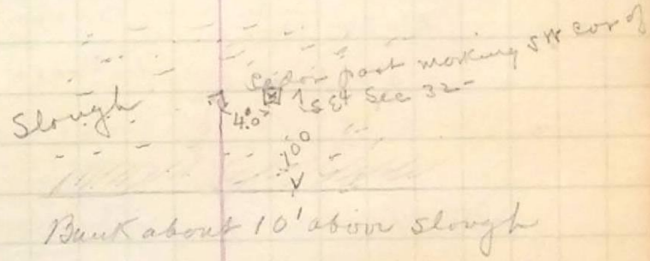

1842.22

X
110

CENTER OF

Monument B
2' WASHINGTON AVE

West
↑