


Location of Buildings
 26th Street - E. of Washington
 Station

Adams Ave

1 s. frame

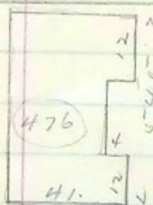


Ave

Distance from center

105+90


Adobe

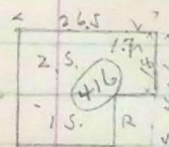

59.40


103+75

2 s. frame

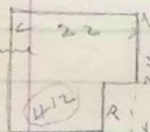

64.8


W. G. Child
 Own

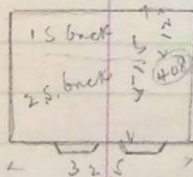

66.8

101+66

W. G. Child, Own
 1 s. brick store

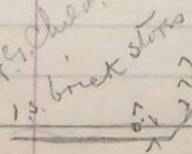

49.58

+66

100


WASHINGTON

Adams Ave

Station Dist from center

106+90


87.3

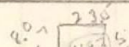

1 s. adobe

105+90

54.30

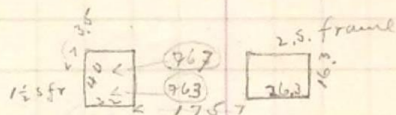

2 s. frame

105+30


67.8



1 1/2 s. adobe

105+00


220.8

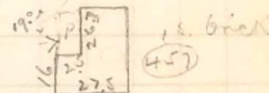

1 s. brick

104+35

110.2

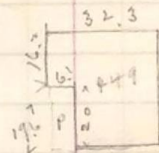


Mrs. Malony, Own
 1 1/2 s. brick

102+80

71.30



1 s. frame

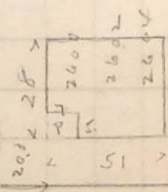

2 s. adobe

+66

58.3

100

AVENUE