26th Street – Location of buildings

	Dist	Sta	Sta	Dist	
JEFFERSON				AVENUE	
				77.0	Corry – 2 S brick
			114+45		
				67.0	1 S. frame
					1 S. brick
			113+45		
				74.5	1 S. frame
	115.8		112	68.0	2 S. brick
	115.8	112+00			
				75.0	1 S. frame
			111+00		
	122.5	111+00			
			108+36	49.4	
ADAMS				AVENUE	

C. J. Brown, Ow.
1 S. frame

1 S. brick

1 S frame

TWENTY-SIXTH STREET

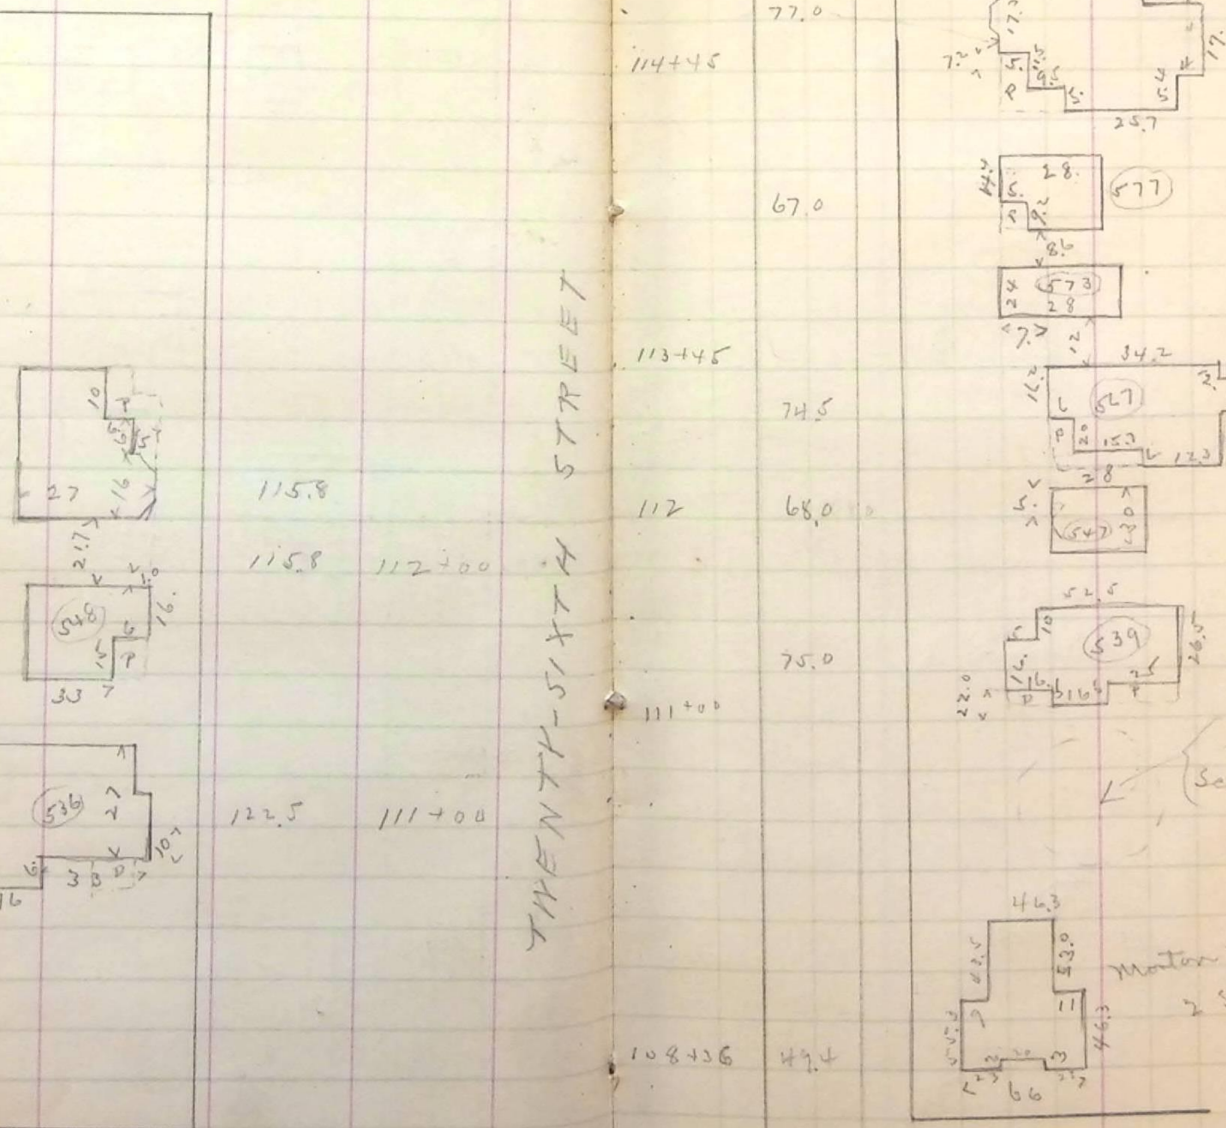

foundation for Scowcroft's new house

Morton Terrace – 2 Story brick