


26th Street - Location of buildings

216 65

Dist Sta Sta Dist

MADISON


AVENUE

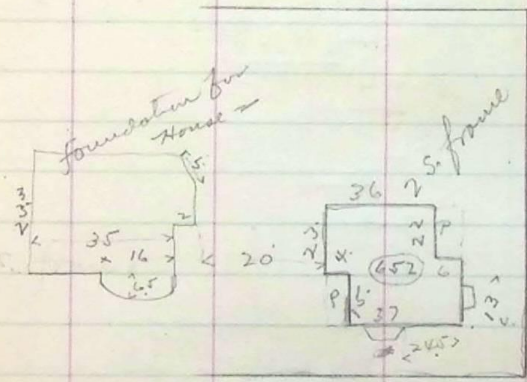

76.5 119+85


Orchard Ave

2 S. brick
C.F. Krouck
Ow.

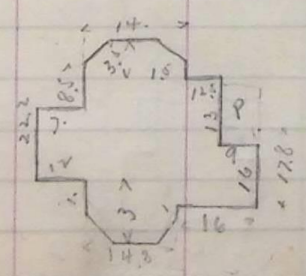

82.2 117+60

JEFFERSON

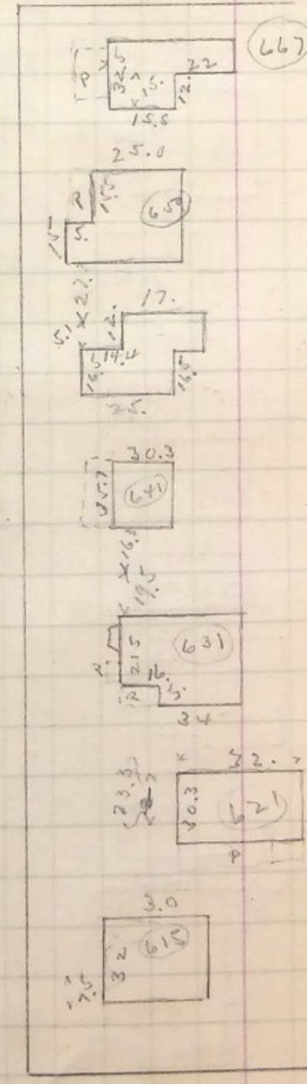

120+85 125.4

667 A.G. Hart
2 S. frame

94.0

1 S. brick

119+85

100.0

1 S. brick

123.4

1 S. brick

118+60

123.

1 1/2 S. frame
J.S. House (Ow.)

117+60 115.0

1 S. adobe + frame

116+90 78.5

1 S. brick

JEFFERSON
AVENUE