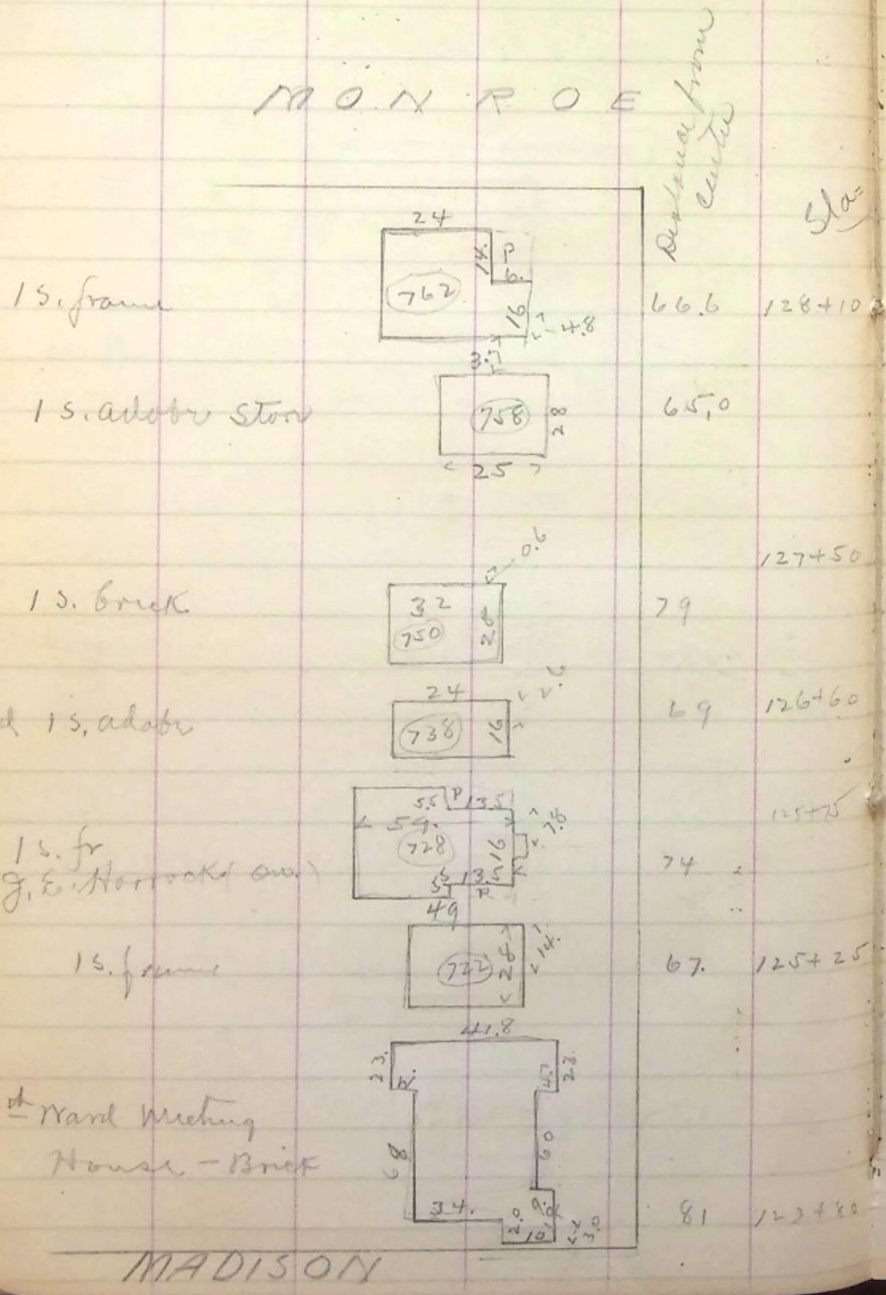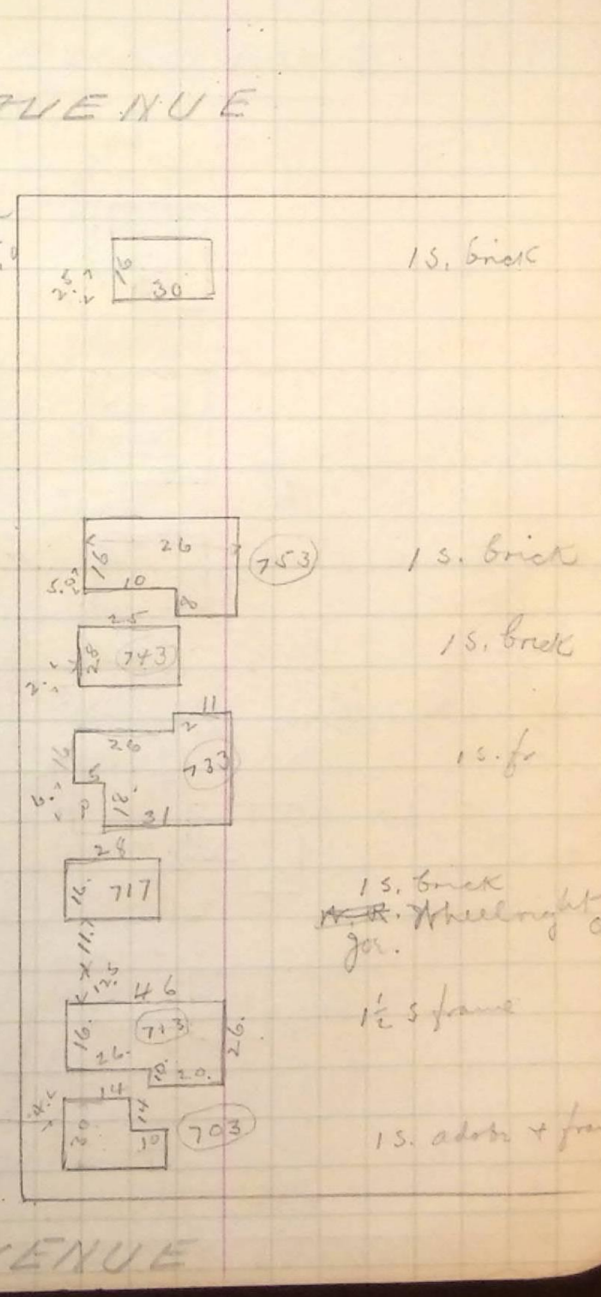26th Street – Location of Buildings