


Runway and location of  
 bet 26<sup>th</sup> + 25<sup>th</sup> streets

TWENTY FIFTH

buildings

1 s brick

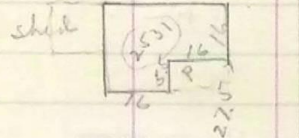


Distance from  
 Sta-  
 tion

Dist from  
 center


STREET

105+60 77.0

1 s brick

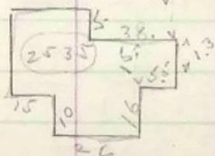


76.5 104+20

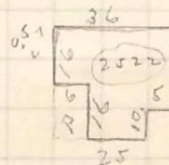


Frank Keyes  
 1 s brick

1 s. fr.

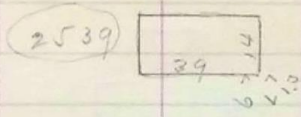


75 104  
 104


1/2 s. frame

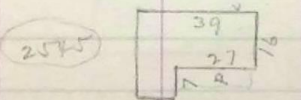

1 s. frame

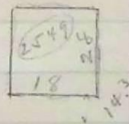


73 103+20 103

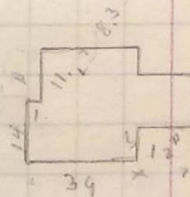

Dr. M. Armstrong  
 1/2 s. frame

1 s. frame


Rose Tibbels  
 own

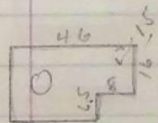

70.7 102+70

1 s. frame

Mrs  
 Northrop  
 own.

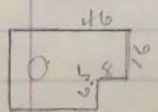

61 102+05

TWENTY-SIXTH

STREET