Monroe ave — but 26th + 25th

TWENTY-FIFTH STREET

		Dist from center	Slater	Dist from center	
2 s. frame	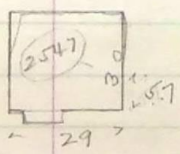	75.0	103+45		
Jr. H Farmer (ow) 2 s. frame	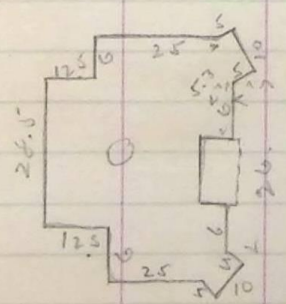	75	102+60		

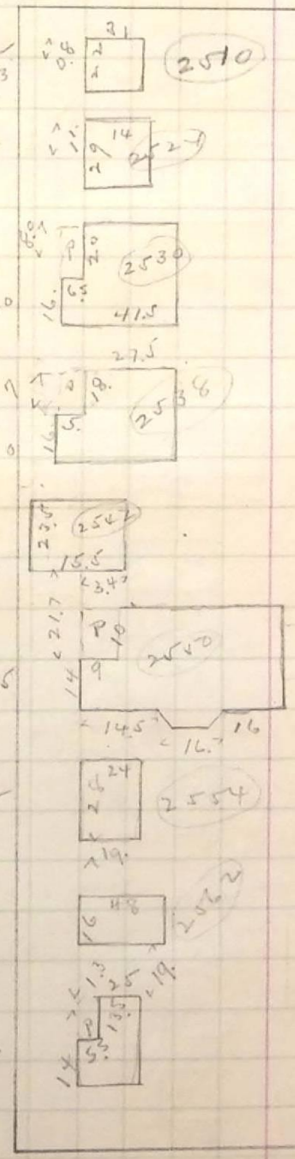

106+30	109.3	2510	2 s. frame
105+30	86		Will Fungr - ow - 1 s. adobe
104+90	94.0	2530	1 s brick
104+25	93.0	2538	1 s brick
		2542	1 s brick
103+45	90.5	2550	shed 1 s. brick
	75	2554	1 s. adobe
102+60		2562	1 s frame Ferringer Co
102+10	76		1 s frame Ferringer, ow

TWENTY-SIXTH STREET