


Orchard Row -

TWENTY-FIFTH

Distance West from line  
Connecting Stations  
119 + 20.7 of 25th St -  
+ 26th St

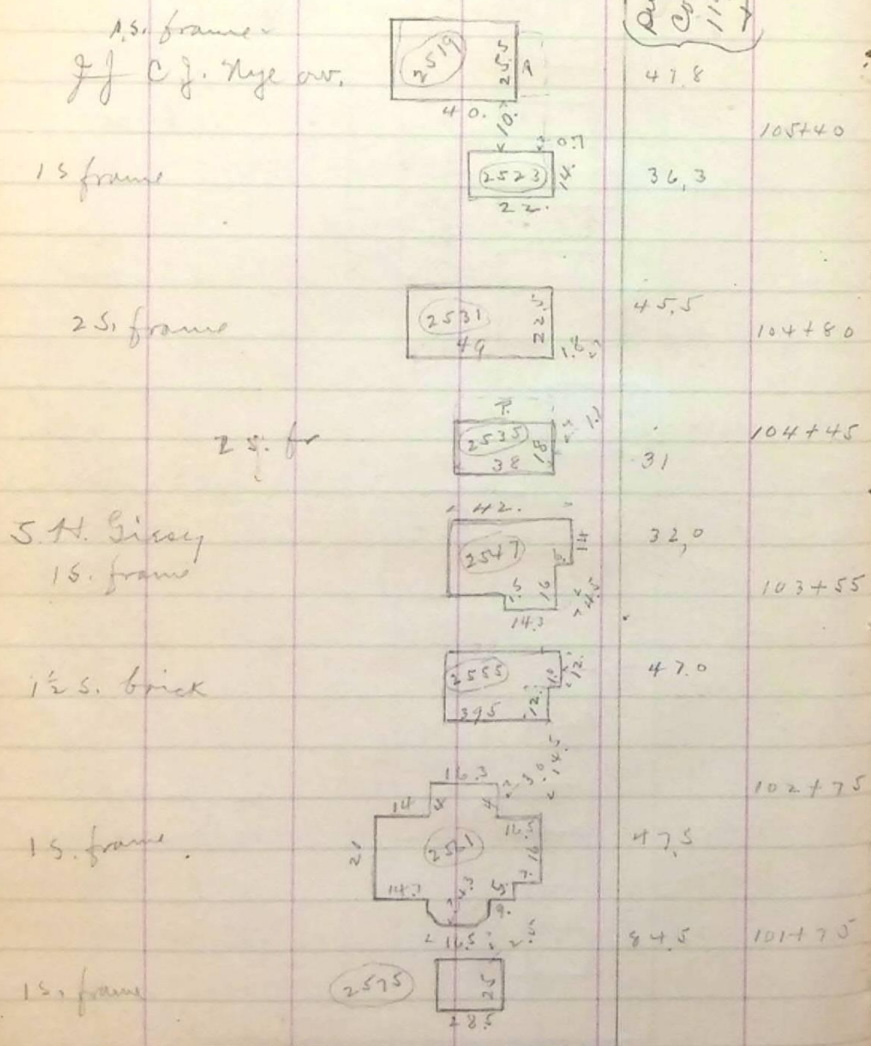

TWENTY-SIXTH STREET

Distance East  
from above line  
being the line  
Connecting  
Centers of  
Manholes  
on 26th +  
27th

STREET

