Jeffersonian air

(Continued on next page)

Distance from center

Slatter

Dist. from center

104+40

102+0

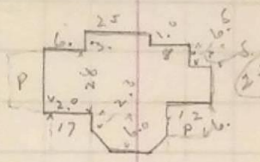

J. A. Whalen owner
2 S. brick Res

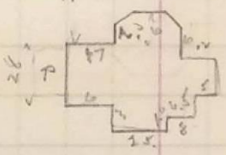

O. E. Hill owner
2 S. brick Res

1 S. frame

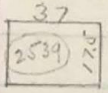

104+40

70.0

103+10

82.5

2 S. brick
Residence of
J. Marks

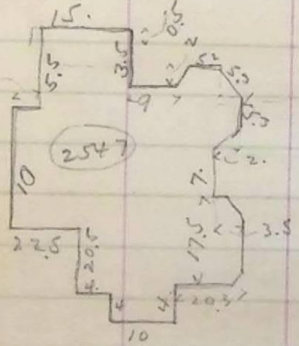

103.

101.5

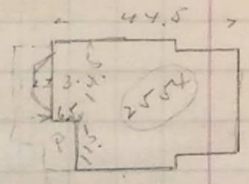

2 S. frame

2 S. brick

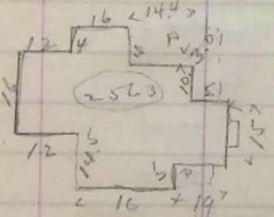

102+45

81.0

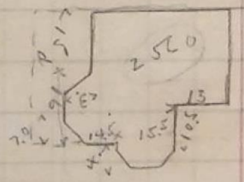

2 S frame

102+45

98.0

101+60

68.5

Bishop Attorney
2 S. Brick

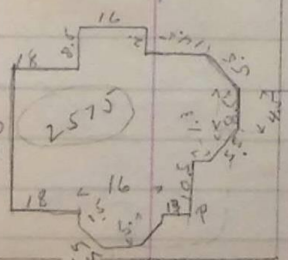

101+10

94.5

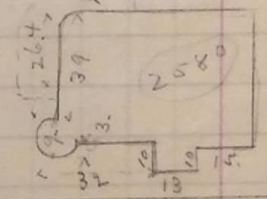

JC Armstrong
2 S. brick + stone

TWENTY-SIXTH

STREET