


TWENTY-FIFTH

STREET

2 s. brick Res.
of Capt. Holmiki

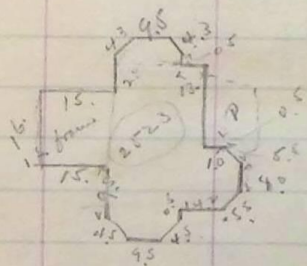

Dist from
center


Station

Station

105+95

Dist from
center

76.0

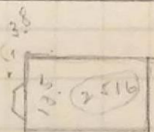


2 s. brick

72.

105+45


105+45

98.2

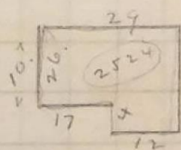

1 s. a. clo. br

M. V. Helfalch (on)
2 s. brick Res. & det.

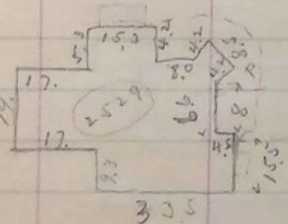


80.0

104+95

104+85

87.8

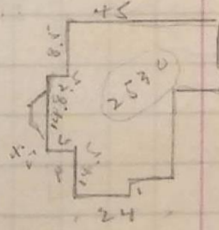

1 s. frame