

TWENTY-FIFTH


STREET

Dist. from center

Station

Station


Distance from center

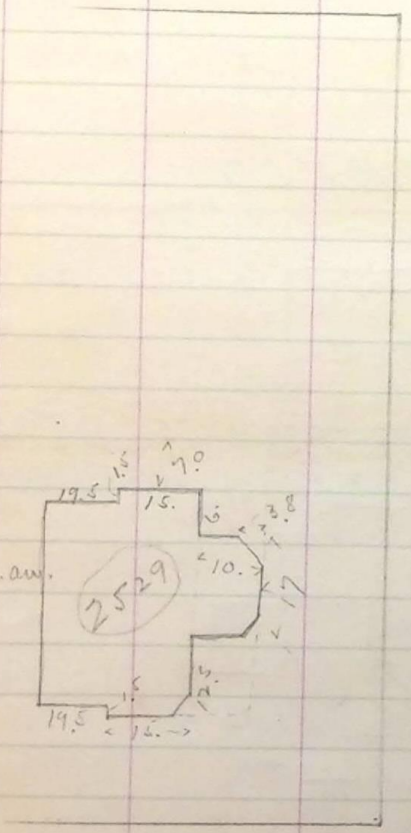

John Brown, aw.
2.5. frame

101.7

TWENTY-SIXTH

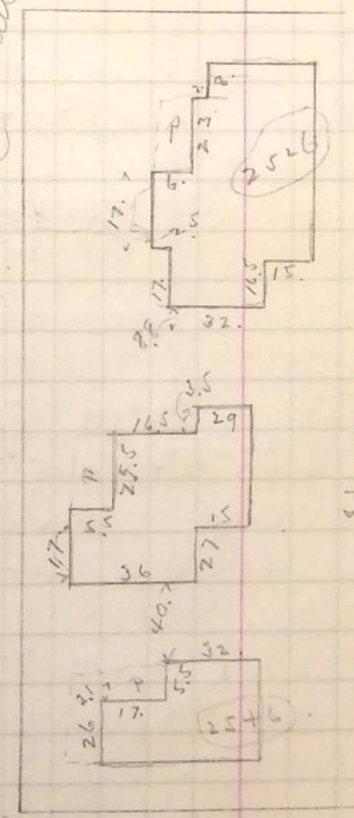

2.5. brick Res. of
Mrs. F. J. Barnett

2.5. brick res -
John Fitzgerald

2.5. brick one -
Geo. Wagoner

104770

10444

98.5

103770

114.0

STREET