Measurements to Locate Street lines as marked on ground to and in proposed Locating Hanson Ave. Monuments ~~+ Monuments Set Permanent + Stone on Corners~~

Cor Hanson Ave + 24th St Sta 115+28.9

Sta 111+83.5

Cor Hanson Ave + Capital Ave

Sta 111+03.5

107+12.9

Hanson Ave + 25th St
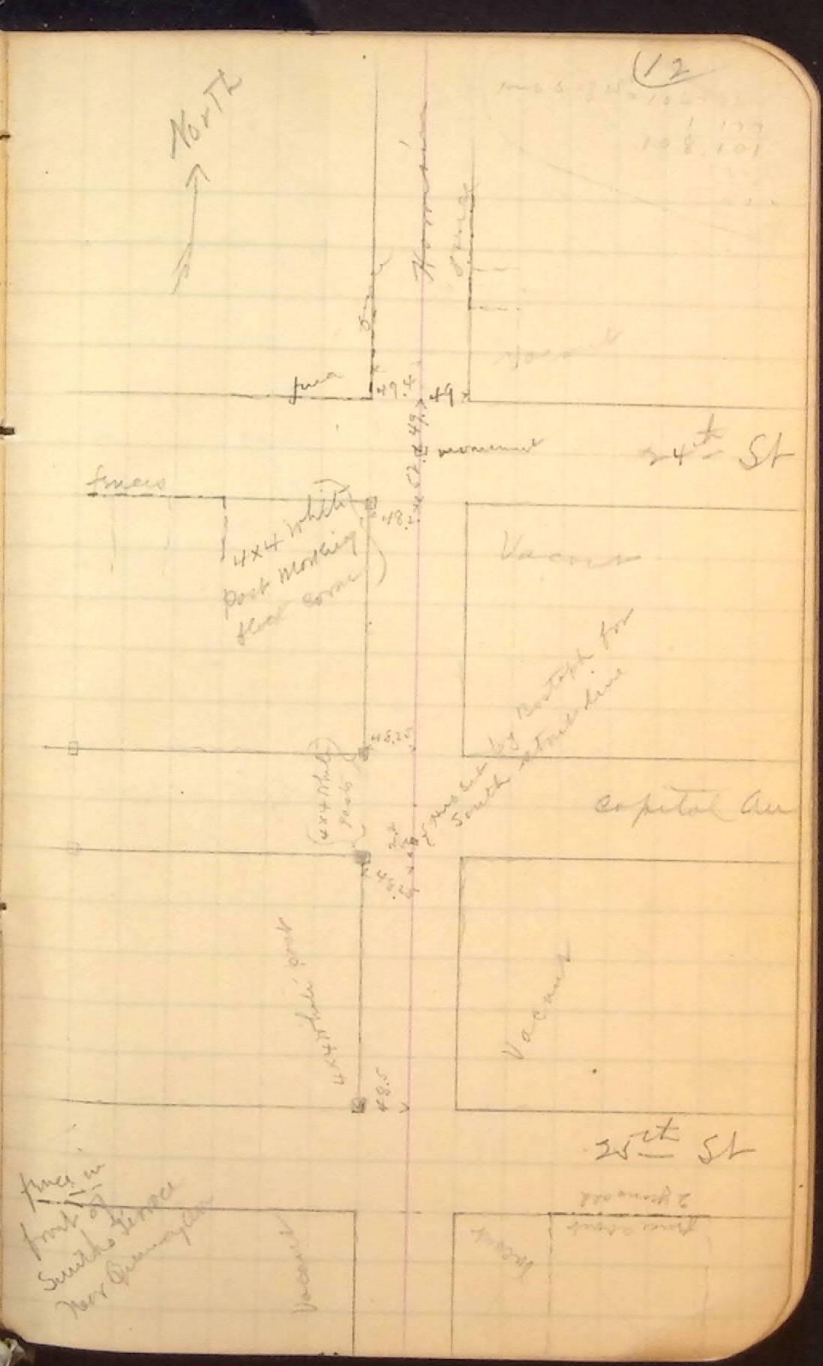
Sta 108+10.1