

Setting Monuments

Sept 10

23rd Harrison -

Set red sand stone Mt. - "O.C.S. No 103"

Found old 12x12 Hub 0.6 North -

Position of monument located by

measuring 1237 north of Hub

previously set (p 22) H-3 on line of

H-3 and Mon. at 24th Harrison - and

setting thence East 0.03

References

22nd Harrison


Set "O.C.S. No 106"

Reference: Nothing to the T.

Set 3.54 north and 0.6 East of H-2

(on p 22)

47

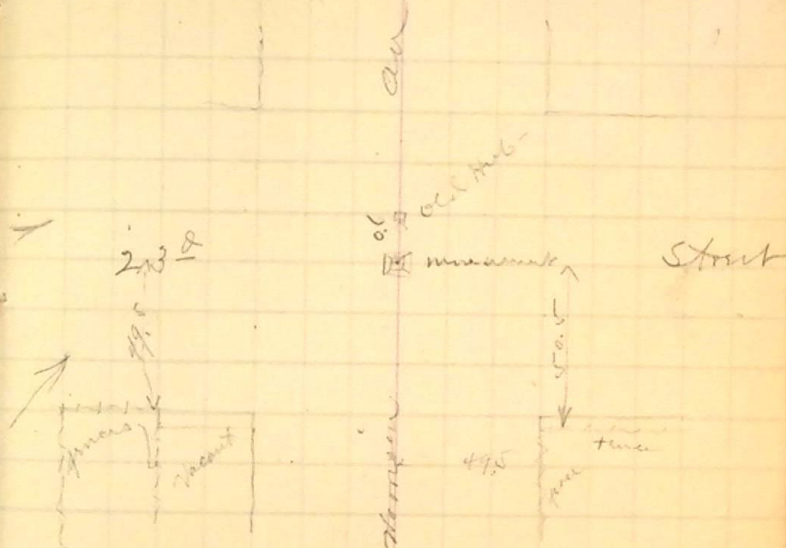

NOTE: Numbered faces of all monuments set north. own.