Location of Buildings on 23d Street – between Adams & Jefferson Sept 15

Jefferson
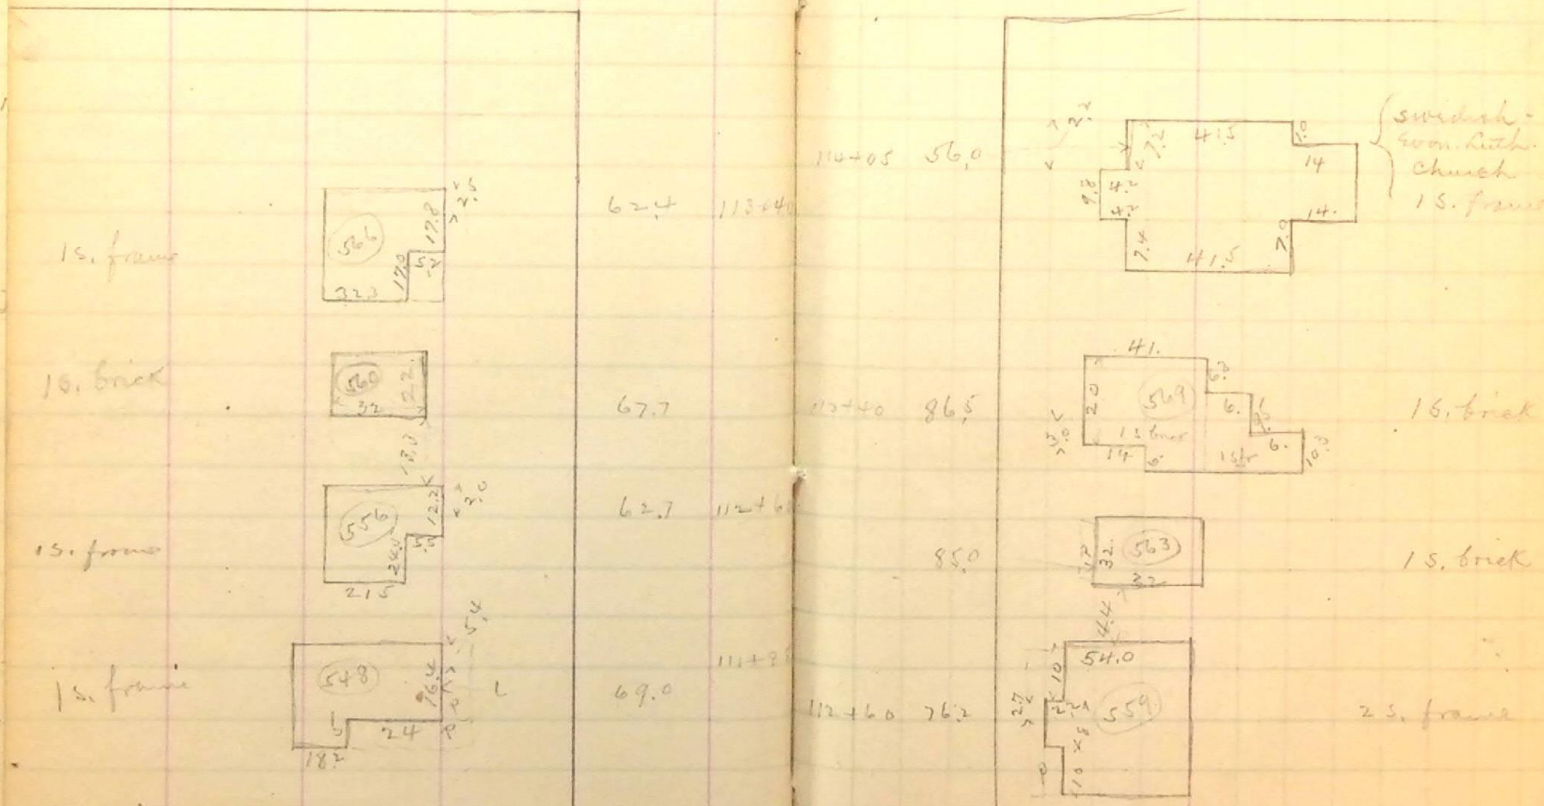
Avenue