



23<sup>rd</sup> [continued]

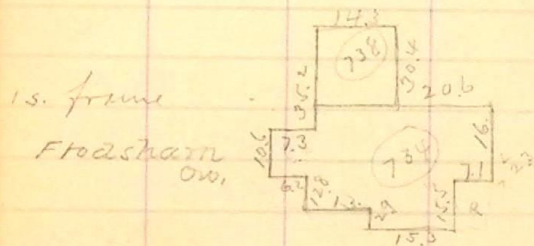


73.5 126+15

127-15 89.0

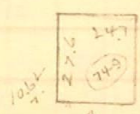


15. frame

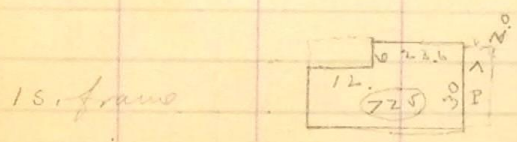


72.0

125+60

89.0

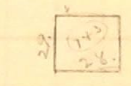


15. frame

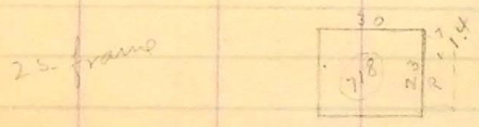


71.0

125+25 126+15

89.0

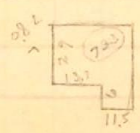

B white over  
15. frame

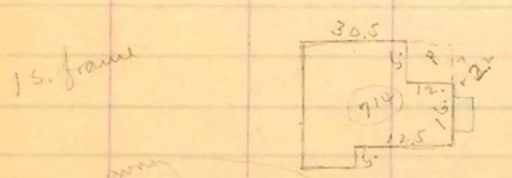


70.4

124+50 125+60

89.2




15. frame  
B. white over

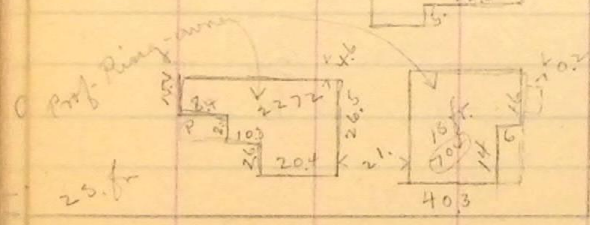

70.3

124+01 125+05 80.4

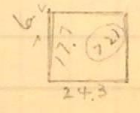

15. frame

MADISON

AVENUE

52  
44.15  
38.75