Monroe Ave

1S. frame.	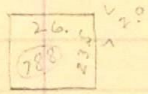	64.3	129+95
Orson Riser. ow. 1S brick	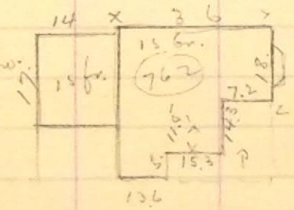	81	128+20
1S. frame	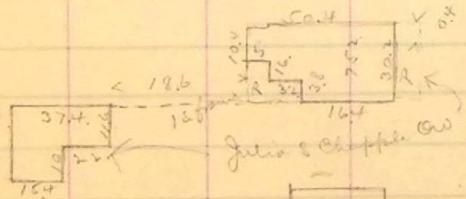 Julia S Chapple. Ow	71.3	127+70
1S frame Mrs Moore ow.	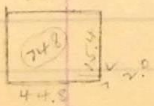	49.7	127+15

		128+55	75.3
1S. brick	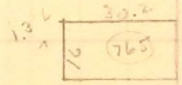	128+20	94.2
1S. frame M. L. Fletcher, ow.	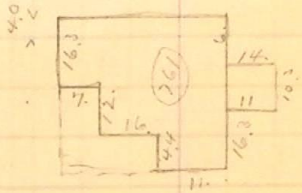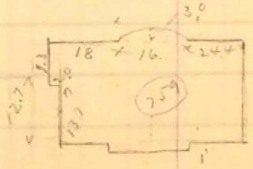	127+70	94.4
2S. frame M. L. Fletcher ow.