


Location of Buildings  
on Monroe Ave -  
Box 24E + 23E

23rd Street

Sept '92

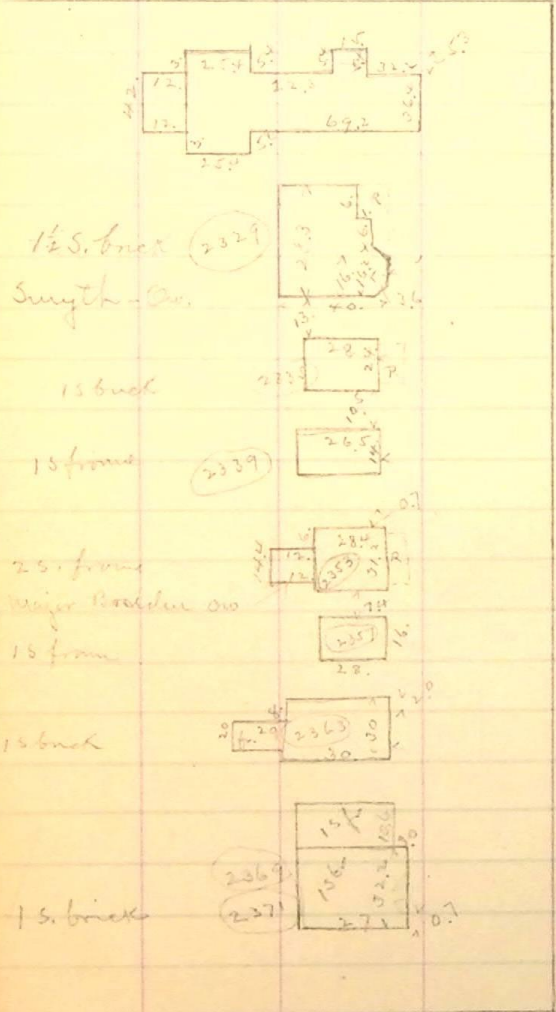

24th Street

62.	120492	120492	783
76.2	120420	110420	80
76.2			
76.2			
68.0	112460	117+80	79.2
69.0			
69.6	117+80		68.0
67.2	117.		68.0

