

Location of Buildings on
bet 23rd + 24th Sts -



on

Madison Ave

55

TWENTY-THIRD

STREET

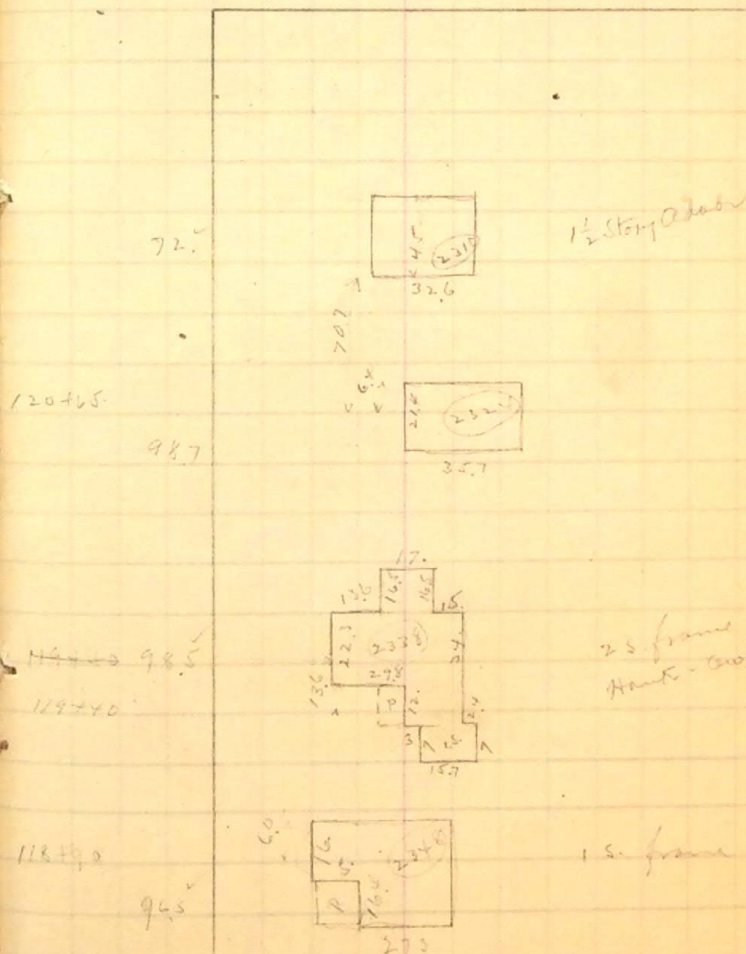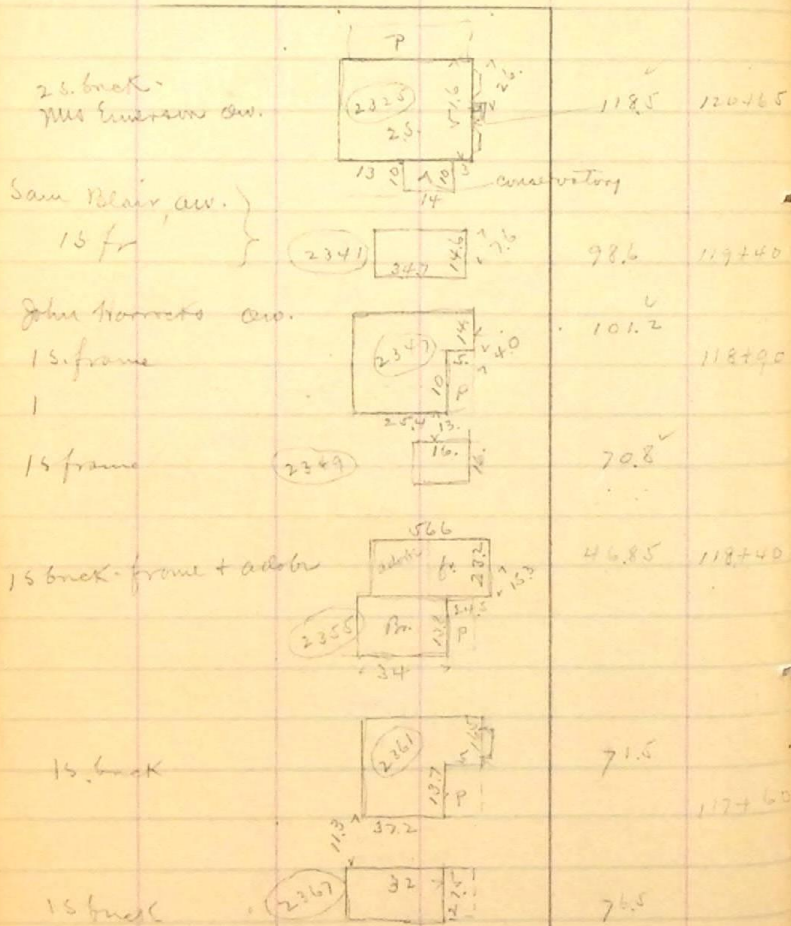

TWENTY-FOURTH

STREET