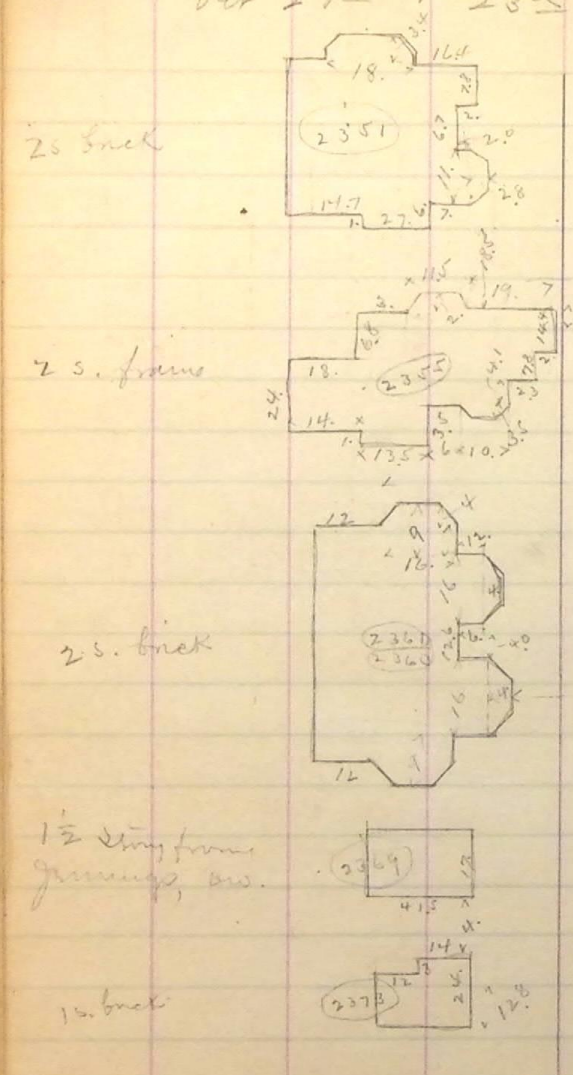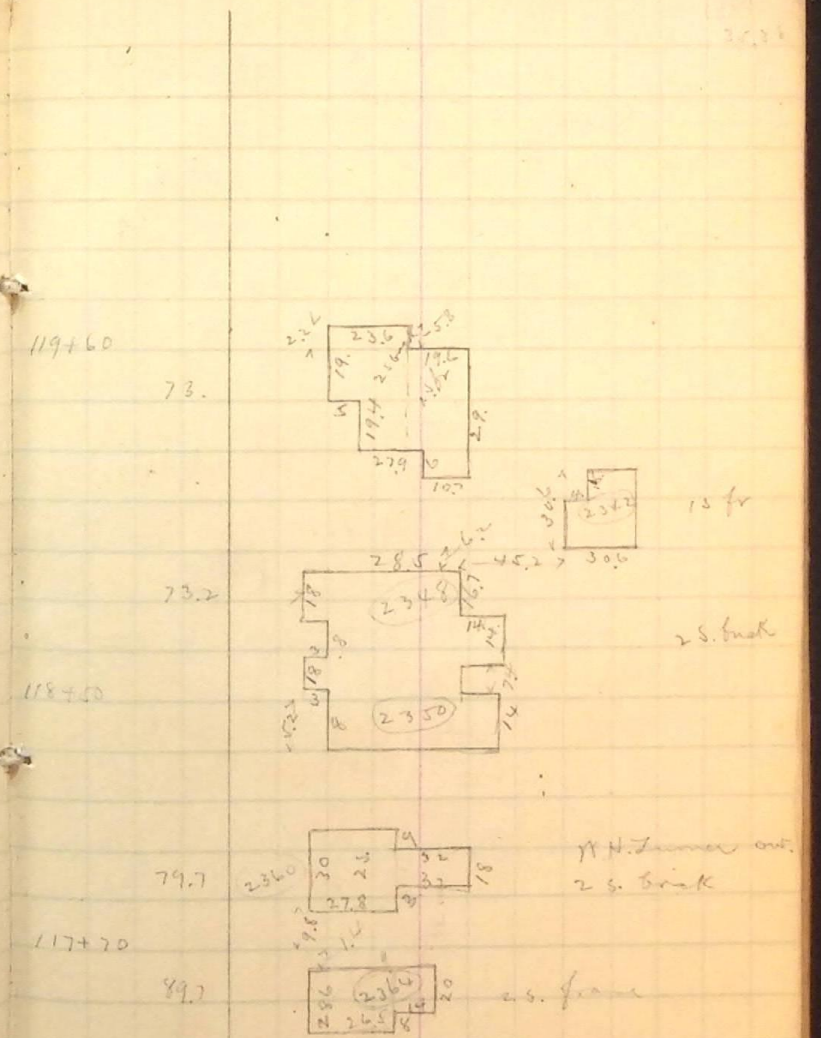Location of Buildings on Jefferson Ave
Lot 24 + 25