


Adams Ave -
Location of Buildings or

TWENTY-THIRD

STREET

15. back

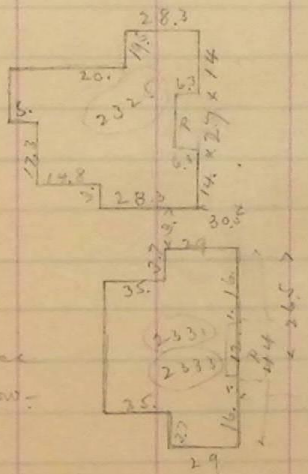

25. back terrace
plus other on the av.

15.8

119-95

Vacant