

Resolving Co. Mon. 47
 Mar 28


A. F. PARKER,

B.19

359°58'
 269°58'+
 179°59'
 A 90°00' - 1
 10 | 899 55
 89°59'30"


chk

Arranged by
 A. F. Parker
 Feb 18 - 1899

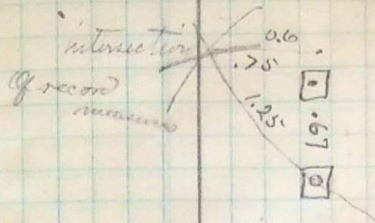

Meas.

Mon.

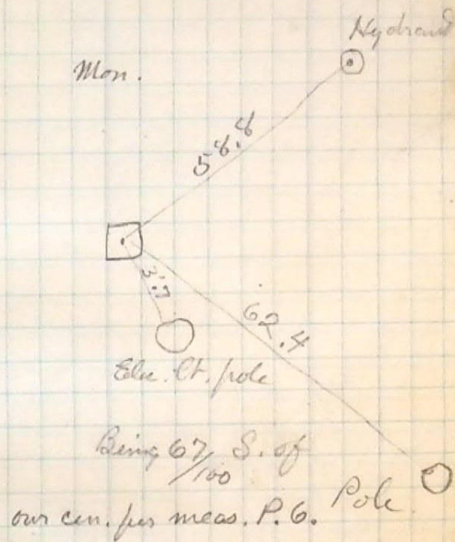

A. F. PARKER,

B.19

Put on cen. lot, above ad Cen. Spring

Cen. Main 2 lot as set by Intersection P. 11