


For Cross Section City Hall  
Grounds - Mar. 28

A. F. PARKER.

A. F. PARKER.

- 381.20
- 49.5
- 

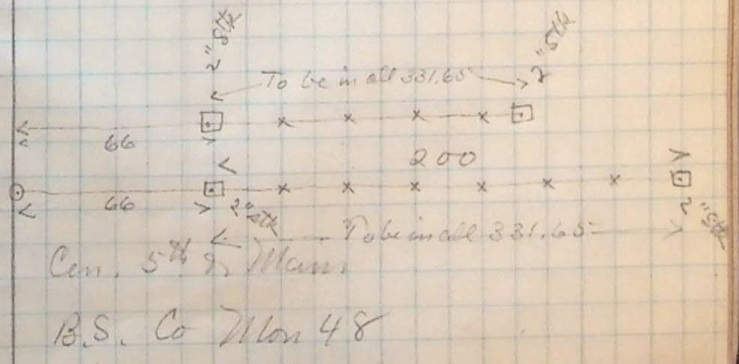

B.S. Co Mar 48