


Mar. 30 1889 14
 City Hall Grounds.

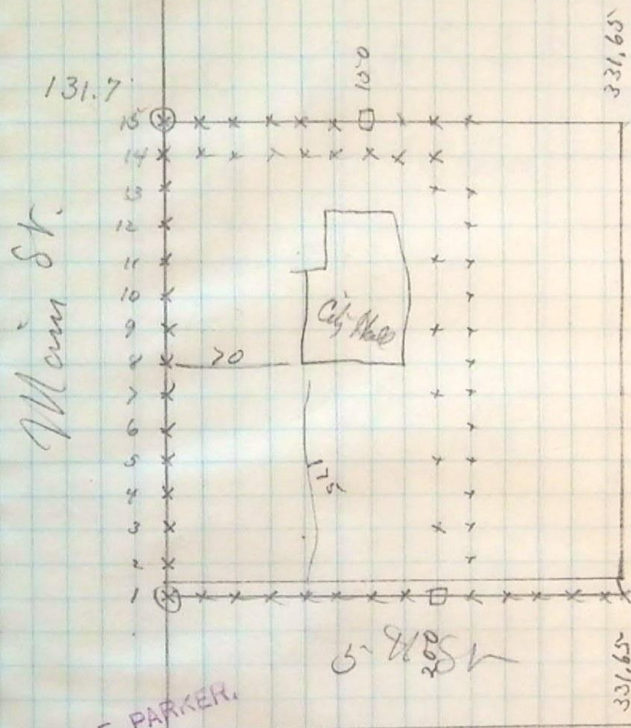

□

70 ft to N.E. cor City Hall

⊙

175 ft. $\angle 90^\circ R$

□

A. F. PARKER.

S.W. cor
 Main & S. St.

A. F. PARKER.

f.S. on Main St., W. line S.