


Survey to determine south line of  
 Central School Grounds - being  
 the south line of Lot 8 - Block 19  
 Plat A

To determine position of old lot lines on  
 this block - I set up on Mount Con. Grant  
 and 26<sup>th</sup> and run toward sight on Mount  
 Con 26<sup>th</sup> & Grant as follows - bottom of page up -  
 Sta 107 + 62.44 Monument at 25<sup>th</sup> St  
 with line of buildings -  
 Iron fence line now there and  
 the same corresponding with  
 107 + 12.90 - Sta for south line 25<sup>th</sup> St -

board fence line as shown  
 Sta 104 + 47.54 = Sta for line between 9 + 8 - find old  
 mark of same about 0.6  
 to monuments - I find old fence  
 Sta 103 + 14.86 = Sta for line between lots 10 + 9 according  
 to this line as shown in sketch  
 monument - I find old fence line 4.24 + 4.64 north  
 Sta 101 + 82.18 = Sta for line between lots 17 + 10 according to  
 Sta 100 = Center 26<sup>th</sup>

See page 25

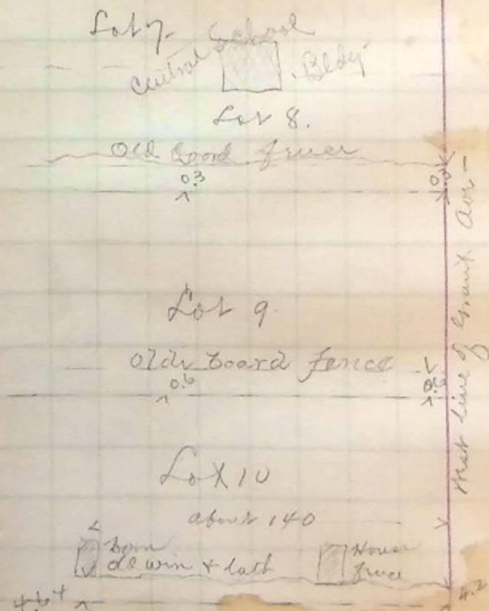

from the great  
 difference between  
 the offset and the  
 two about - I suspect  
 the fence does not  
 mark the lot line

181.57 4.24  
 20 4.64  
 374.86 0.6  
 100.06  
 107.54  
 762.42