


Location of Buildings -

27th Street - Wall to Madison -
for Sewer Dist No 7 - Nov. 92

LINCOLN

AVENUE

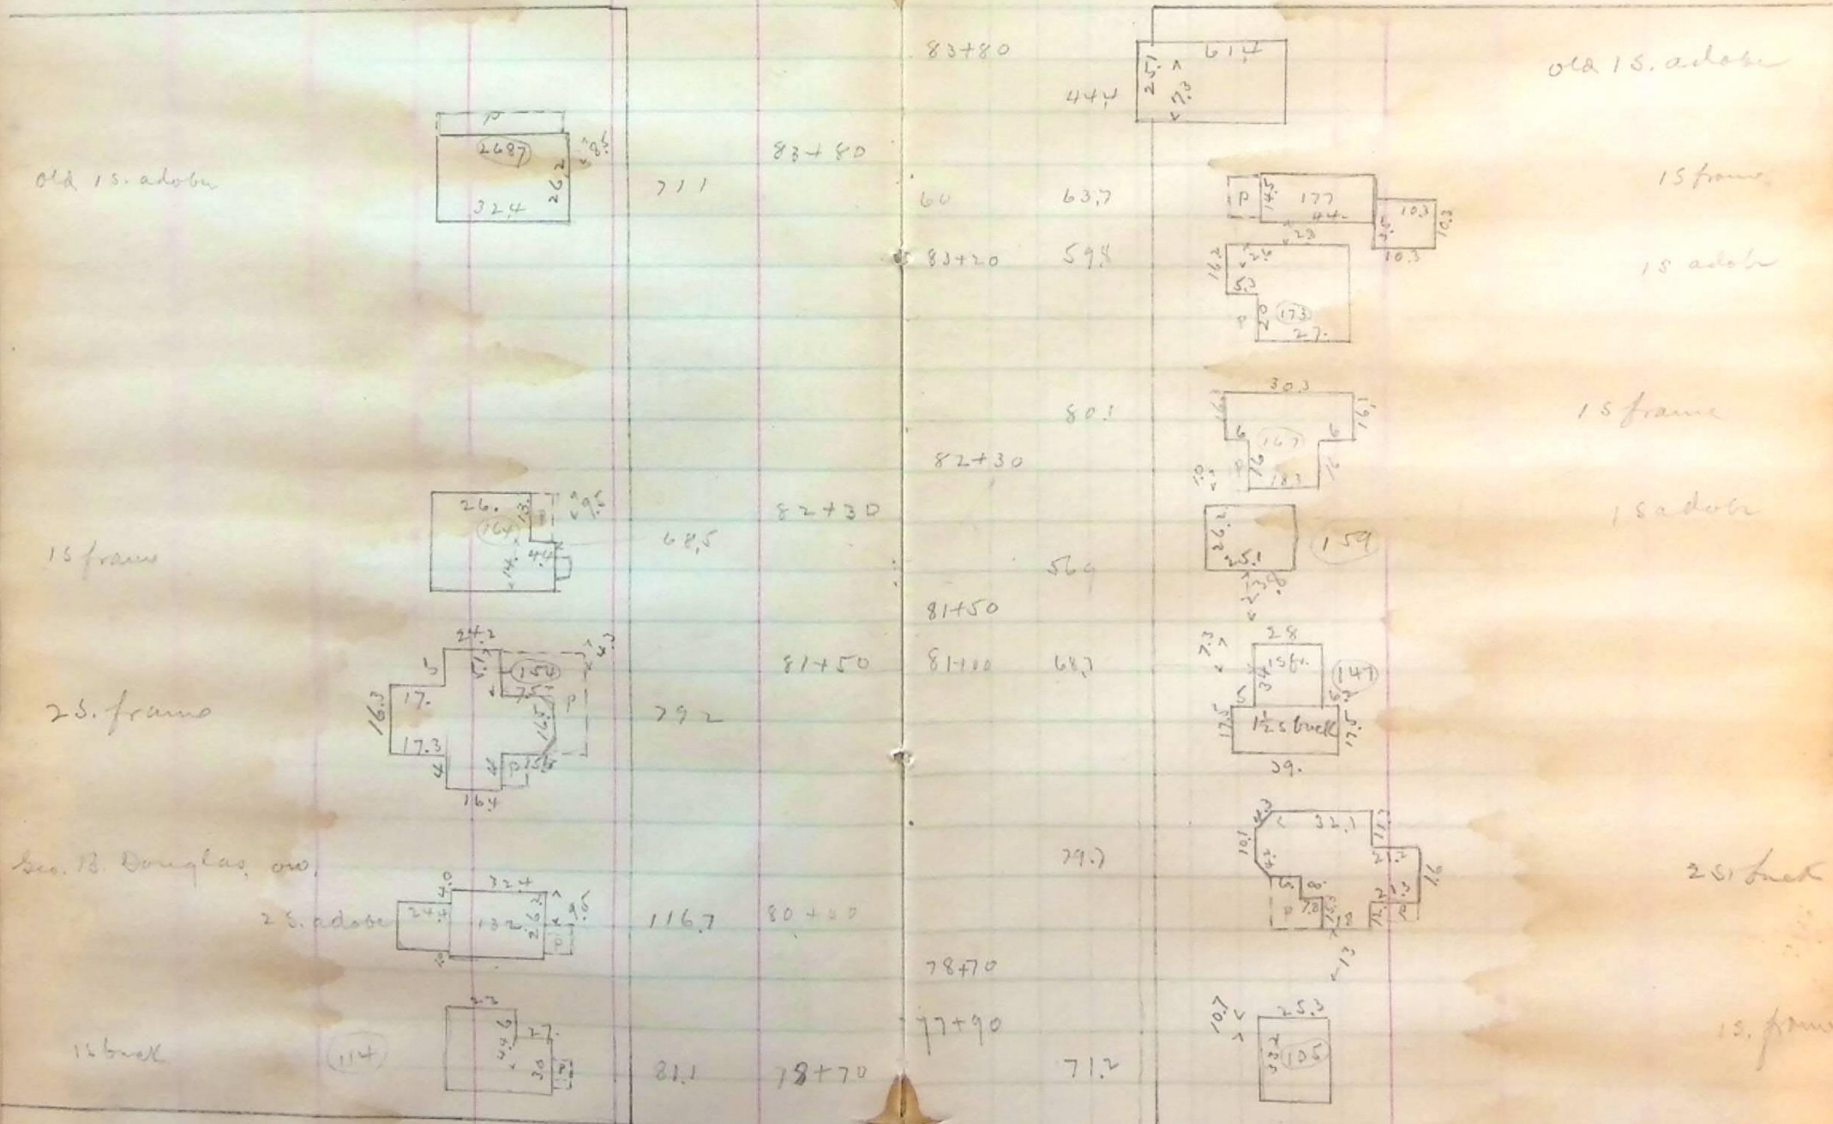

WALL

AVENUE