(Locations continued – 27th St)

Elev 9.

Dimensions, Etc	Distance from Center of Street to Building	Station	Station	Distance from Center of Street	Dimensions, Etc
			88+30	276.5	
				88.5	
			87+95		
				138.	1 s. fr. A. T. Doxie, ow
				91.5	2 s. brick E. F. Tout, ow
Robert B. Willson 1 s. fr.	81.6	86+90	86+90		
				75.5	1 s. br. Jas. Hopson
	66.5				
1 s. brick		86+10		63.6	1 s. fr.
			86+10		T. F. Emmett, ow
1 s. fr.				64.6	1 s. fr. " "
1½ s. fr.	78.5	85+50			
		~~85+50~~	85+50	60.	1½ st. frame T. F. Emmett, ow

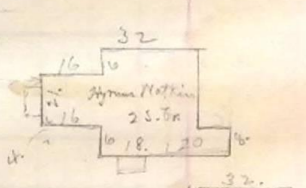

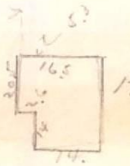

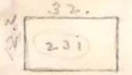

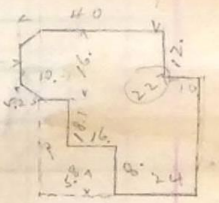

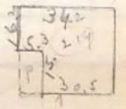

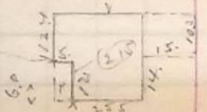

Thos Emmett ow

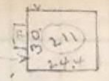

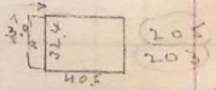

LINCOLN AVENUE