



GRANT

AVENUE

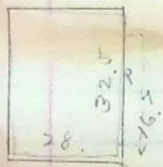


75.2 91+30 91+30

57.5

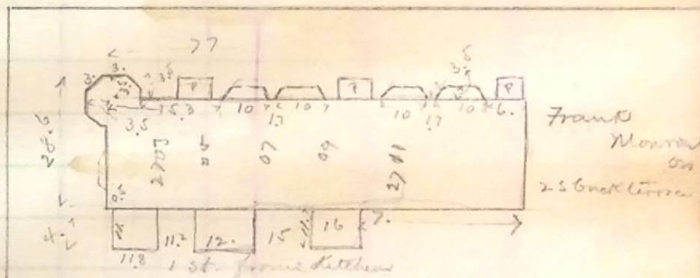


90+30


63.

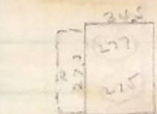

18 front

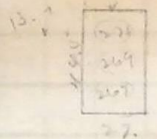

15 back

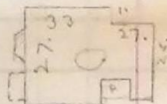


58.8

14 back

Sidney Steiner on

89+30

79.7

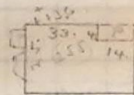


12.5 back

do do

McCormick on

15.1 front

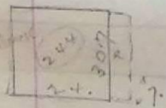


73.9 88+30

72.7

McCormick on

88+30

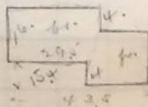

16.5 back