


House Locations on Grand Ave
From 30th North

Distance from center Station

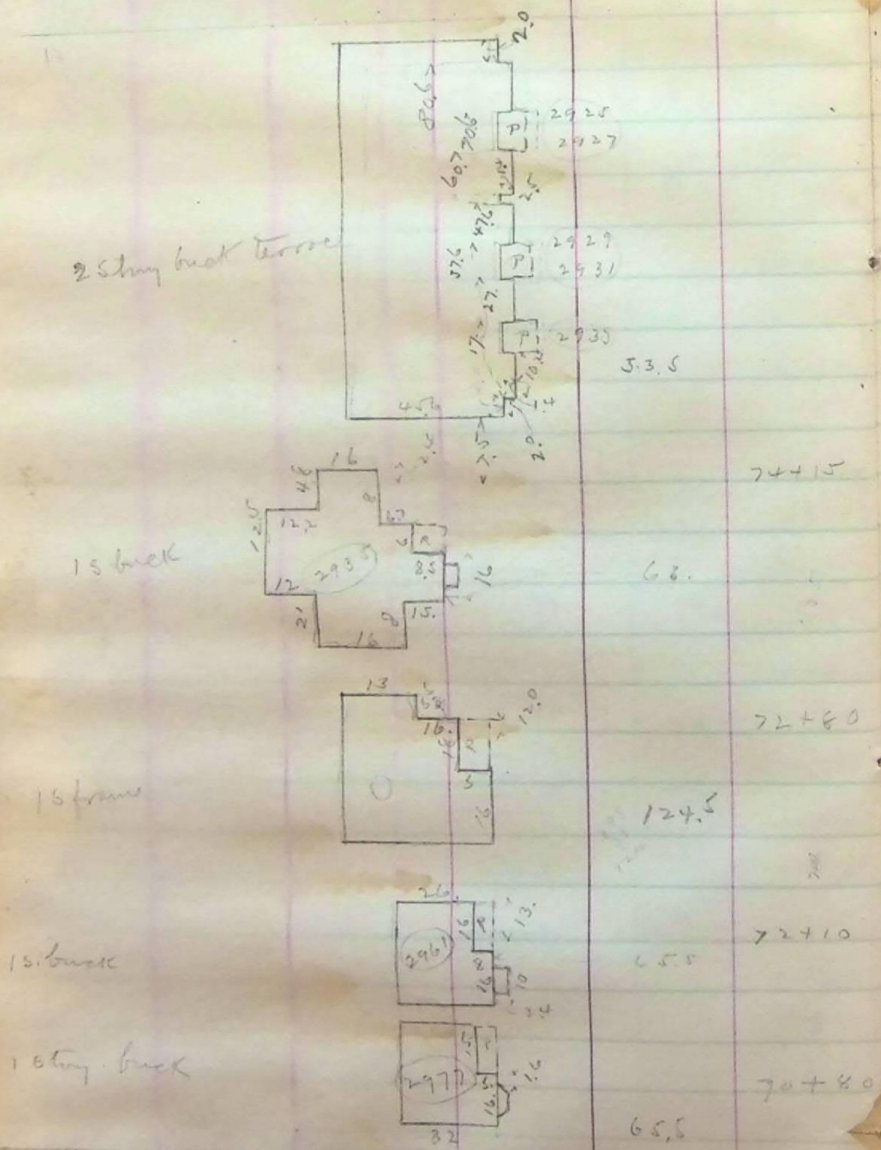

THIRTIETH

STREET

Vacant property
30th North