


Grant 200 - from 26th & 27th
 House Locations - Sylv 13th

TWENTY SEVENTH


STREET

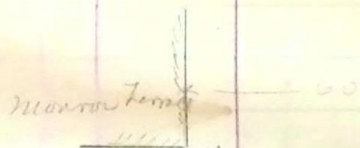

2nd frame




67.7 90+70

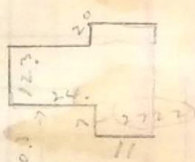

18 fr

1st back

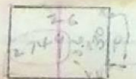


86

88+20

89+70

67.5

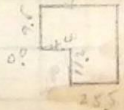

16 fr

2nd fr




123.3

87+60


89+10

85

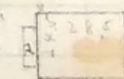


15 fr

3rd back

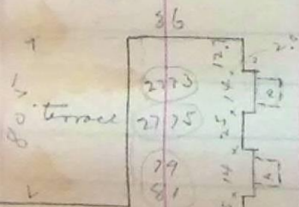

88+20

70

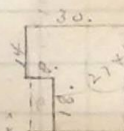

15 fr


1st frame chert.

84+71.85

85+40

85+40

70

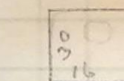

TWENTY EIGHTH

STREET