


Location of Buildings on
Washington Ave - front
25th to 26th - Plot-18

TWENTY-SEVENTH

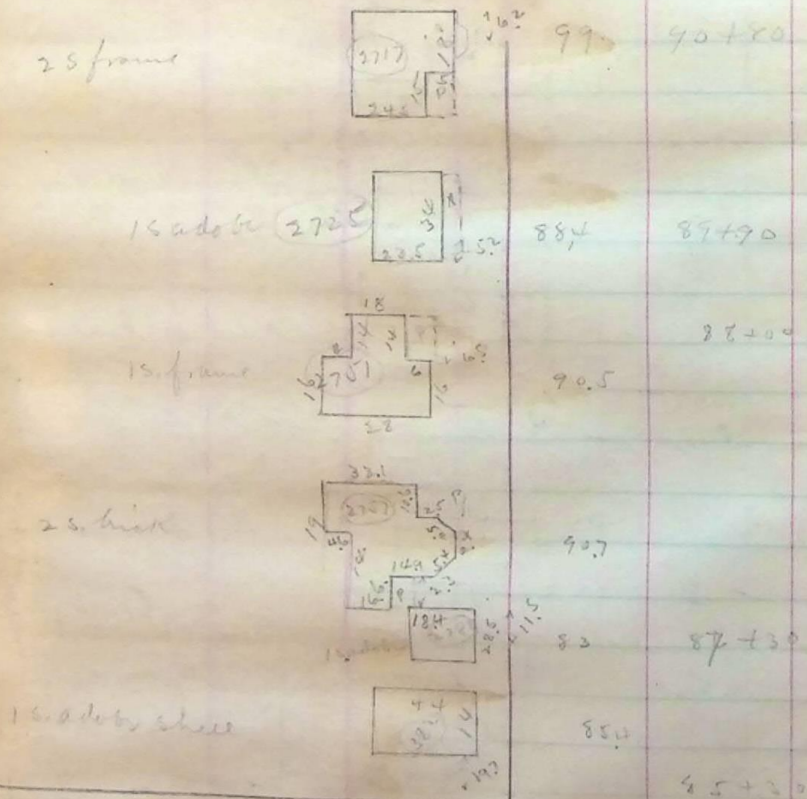


TWENTY-EIGHTH

8417

17

STREET -

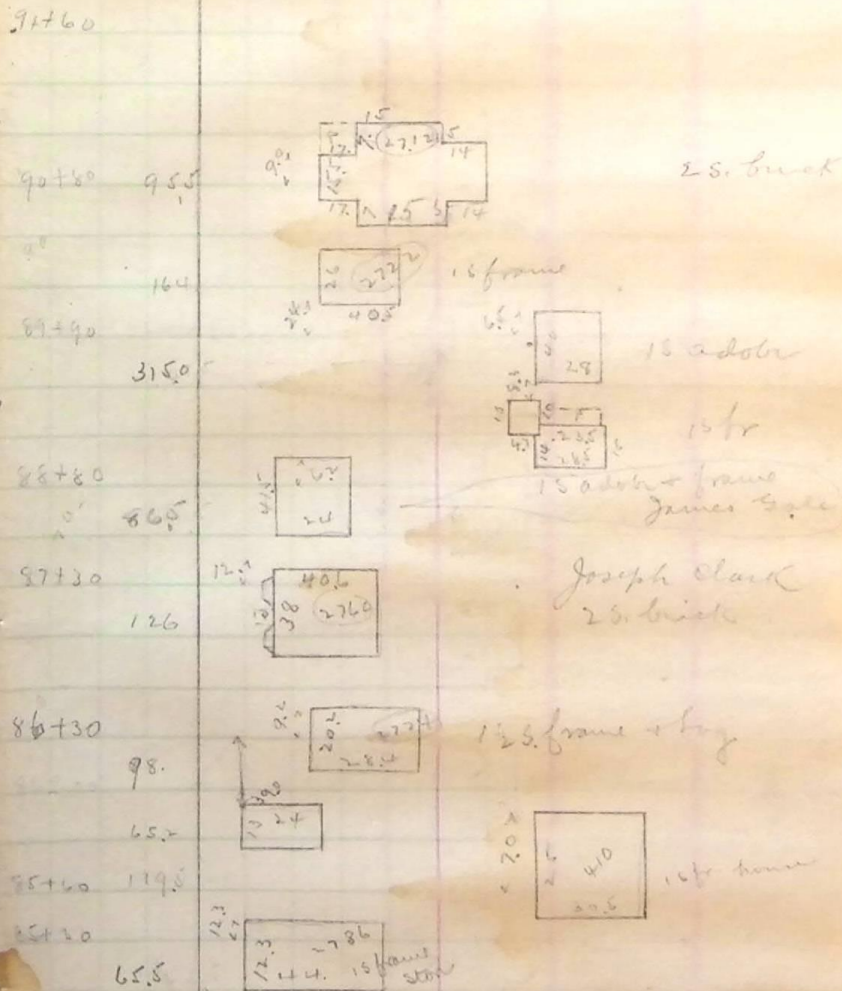

STREET