


Washington Ave -
from 27th to 26th

TWENTY-SIXTH

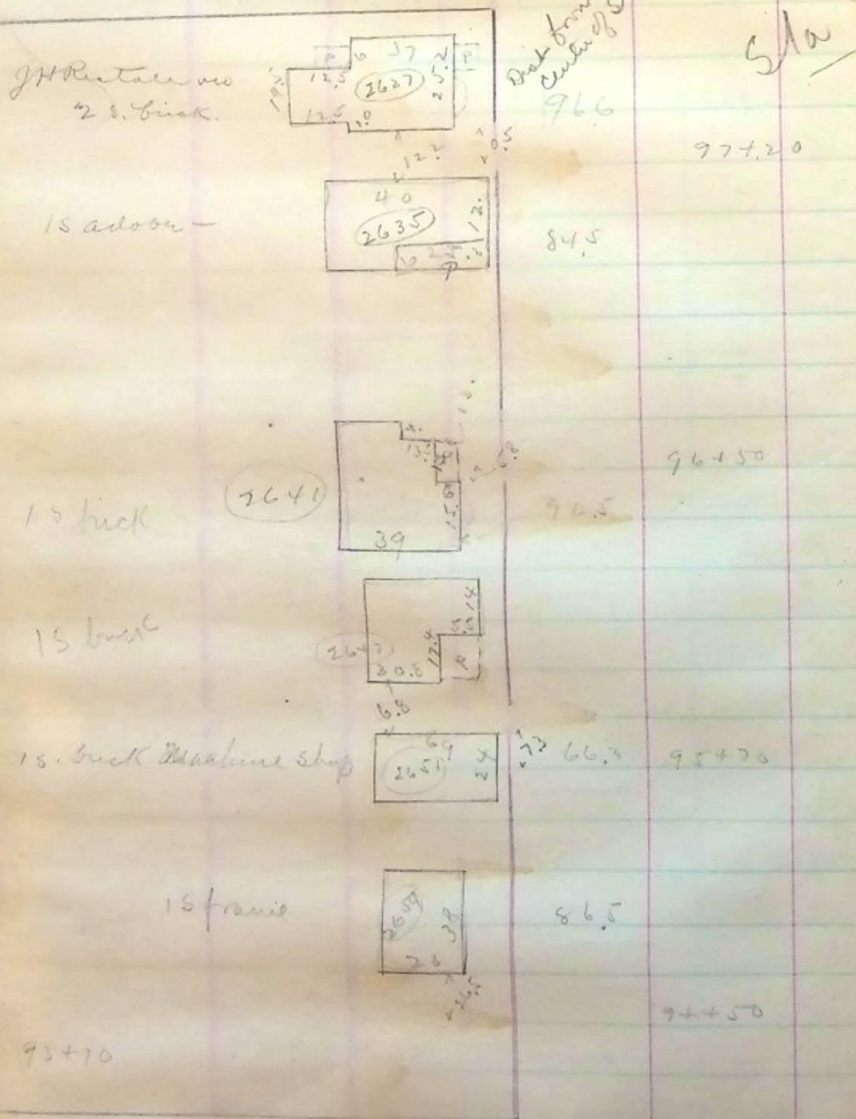


TWENTY-SEVENTH

92+36.3

STREET-

turn
{out from
center of street

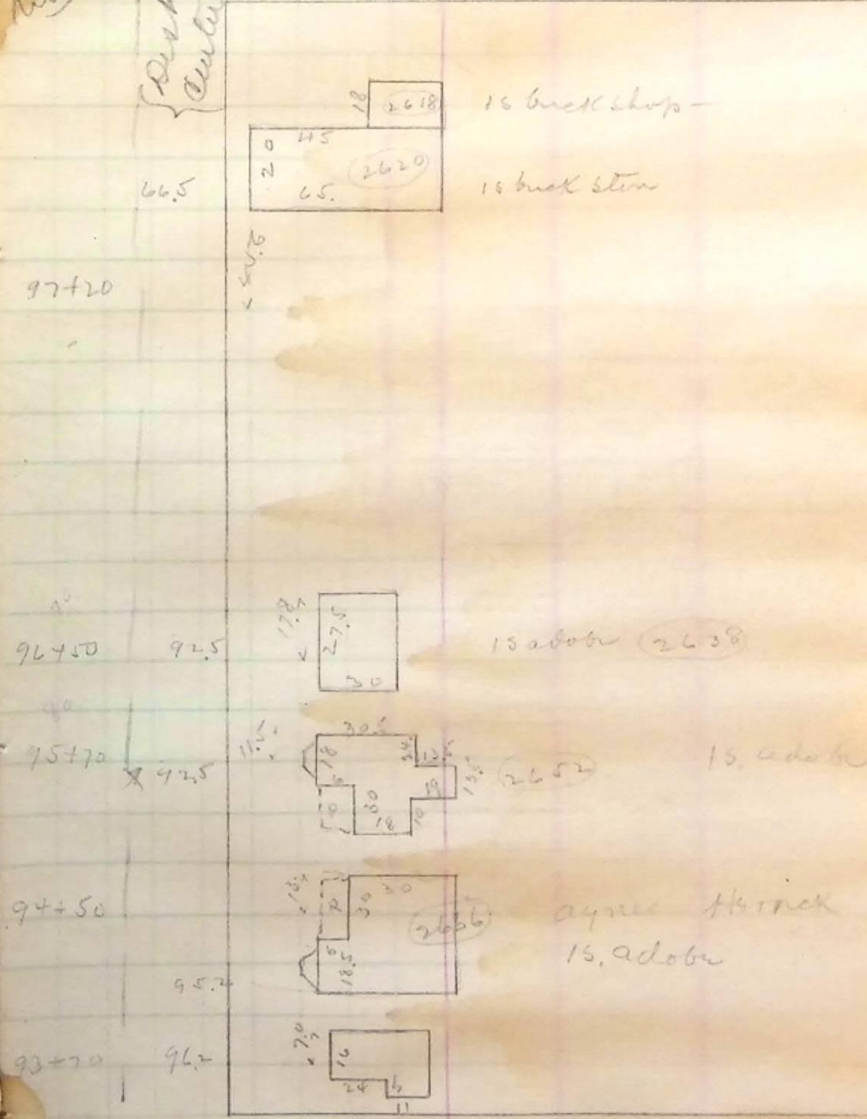

STREET-