


Location of Buildings on  
Jefferson Ave - from 27<sup>th</sup> to 28<sup>th</sup>  
TWENTY-SIXTH

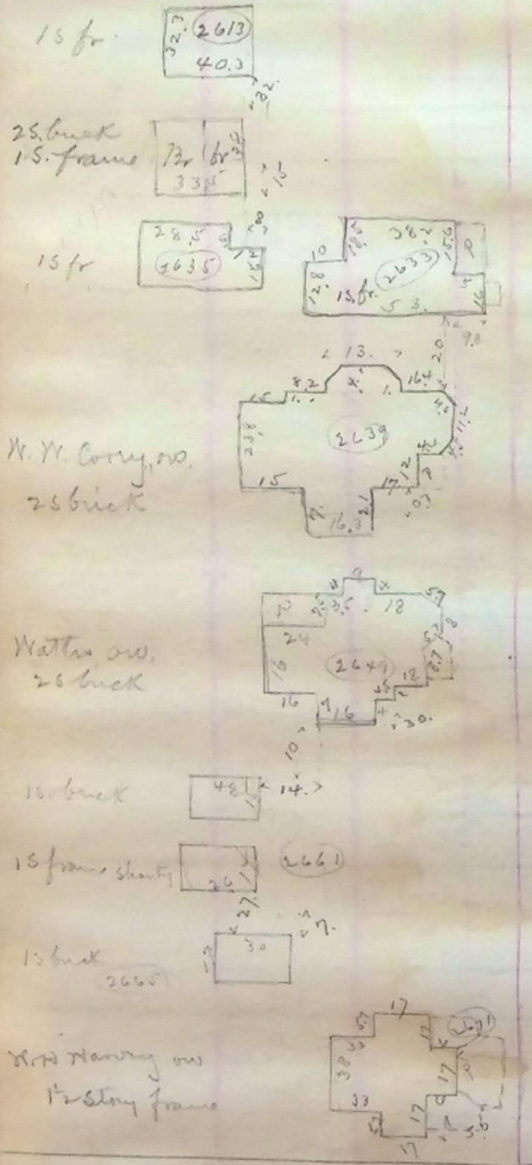

51.5 98+00

190. 97+40

75. 96+40

74. 95+80

130. 89.1

176.5 94+80

158.5 95+00

88.0 94+00

98+00 80

79.5


96+40 88.5

89.1

95+00 89.1

94+00 88

STREET

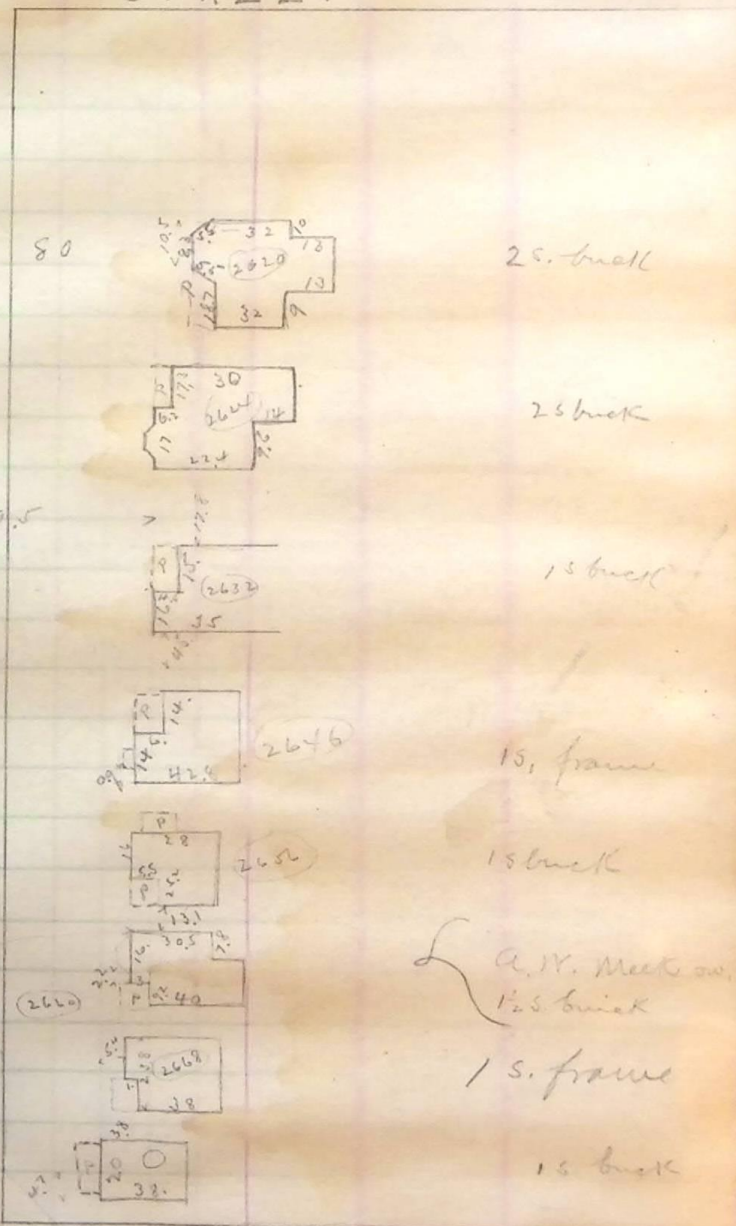

25. brick

25 brick

15 brick

15, frame

15 brick

A. W. Meeks ow.  
1 1/2 story brick

1 s. frame

15 brick

TWENTY-SEVENTH

STREET