


Nov. 92

Survey to locate monument
Corner 27th + Madison

Sights at monuments corners of
27th + Jefferson + 26th +
Madison - Transits at Mon-
uments corner of 27th + Quincy
and 28th + Madison respectively
to determine intersection at
27th + Madison and set
oval shaped (O) cast hub
and drive nail in same
to mark proper point
References as follows

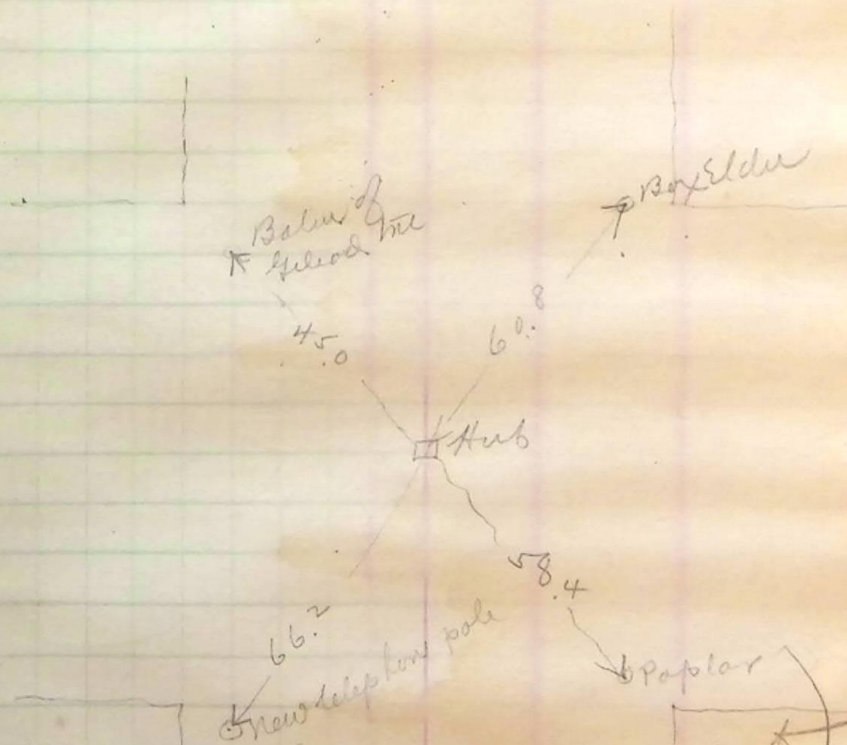

These notes transferred
"Street Monuments" book