

Location + cross sections
of 28th Street ditch -
Nov 18th

Paces	Paces reduced to City Stations
280	92+21
270	91+95
230	90+85
190	89+75
150	88+65
105	87+42
65	86+33
50	85+92
40 paces from center Lincoln	85+64
273 to center Lincoln	84+55
260	84+20
220	82+93
180	81+91
145	80+96
120 paces	80+26
100 paces	79+70
60 paces	78+58
20 paces	77+46
Center Well	76+90.2


$$\frac{766}{280} = 2.73$$

$$\frac{765}{270} = 2.8 \text{ ft per pace}$$

No. of paces from center well on

Paces reduced to City Stations -

Map of Ditch

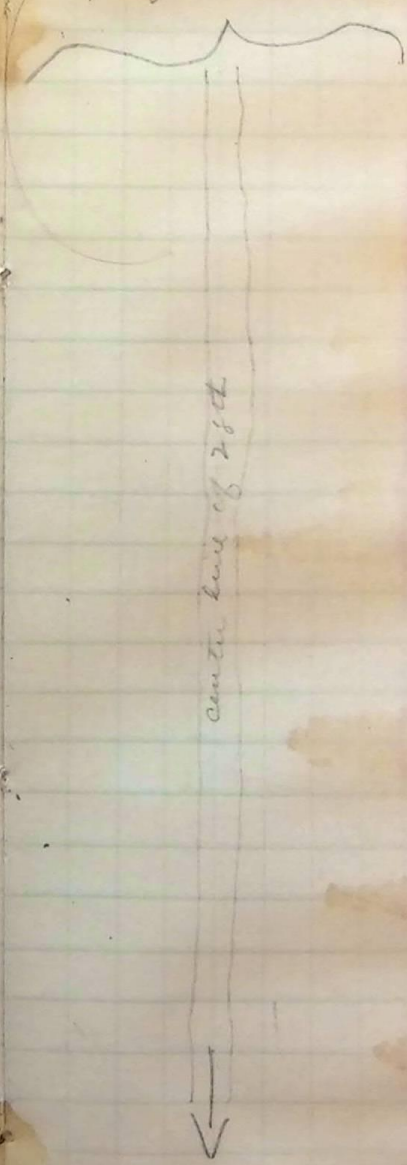

Cross section + depth of Ditch

Traverse line on 10' offset north of 28th center	3	6	14	17	3 d
	4	8	14	17	3 d
	4	9	13	18	3 d
	4	7	13.5	18	2 d
	4.5	10	16	19	2.5 d
	4	7.5	12.5	17	2.5 d
	4	11	16	19	2.7 d
	4	9	14	17	2.5 d
	3.0	6	12.5	17	2.5 d
	3.0	8.5	13	18	3 d
	2.0	7	12	16	2.8 d
	3.0	11	16	20	2 d
	3.5	7	12	15	2.3 d
	3.5	4.5	13	16	2.4 d
	3	4.5	11	16	2.6 dup
	3	8	12	18	2 d

