


# Continuation of check on Kings Addition

Stakes having been found incorrectly set by first check survey (p 27)  
They were reset by Mr. Ellis and then rechecked his last work -  
Same course pursued as in last survey (p 27) - portion found correct in last survey was not moved.

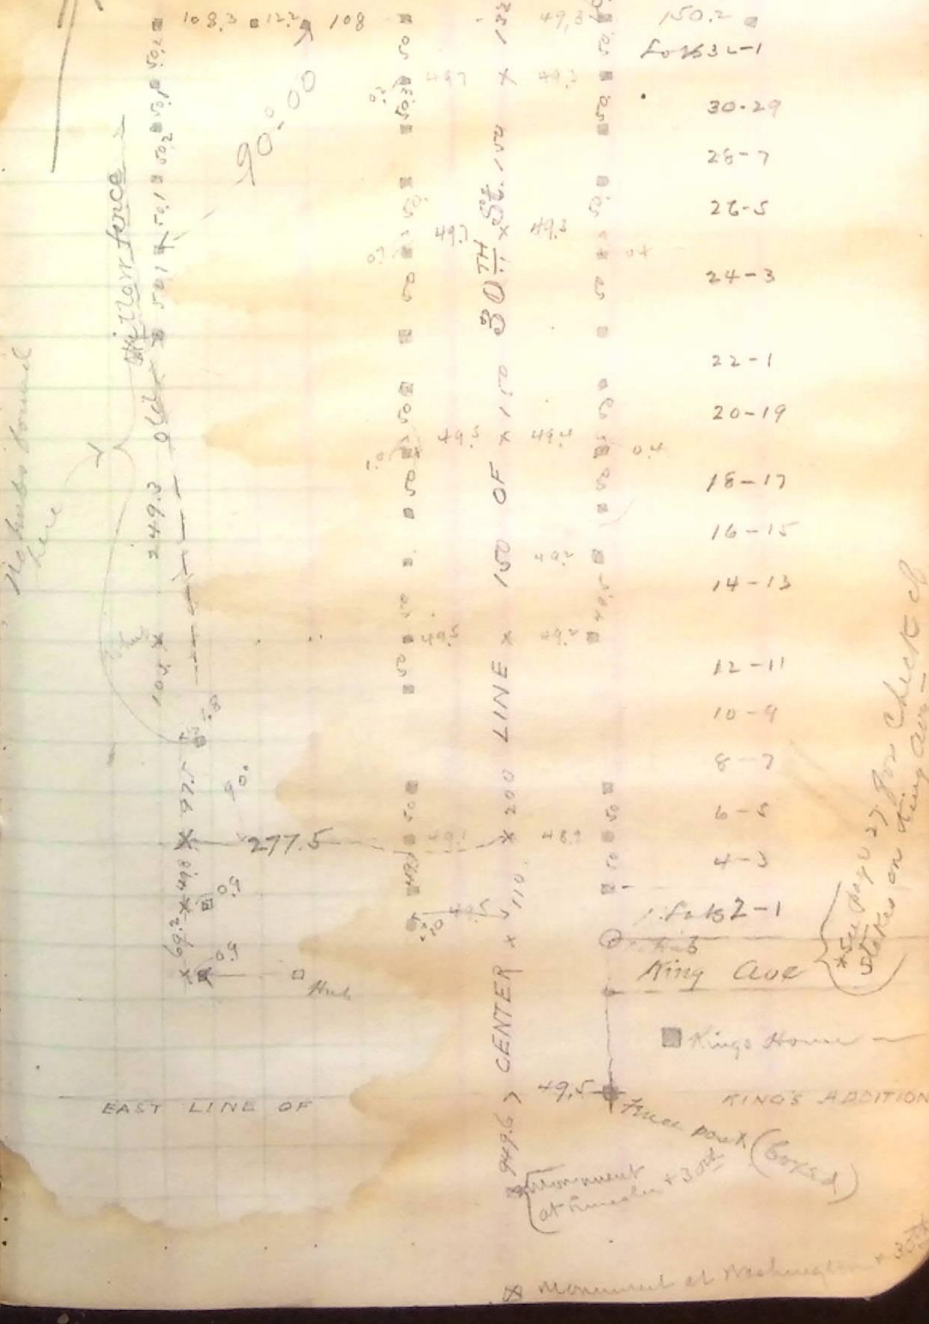

U.P. Main Tract  
KING'S AVENUE  
Kings Home  
Monument at Washington + 35th

