Kings addition Continued

Survey & Check Exterior Bounds
Jan 5th 93-

Measurements made from hubs in
Kings addition—as shown-

Lines marked ~~~~~ are old willows hedges
" " +-+-+-+-+ " wire fence lines
Points " □ are hubs or stakes
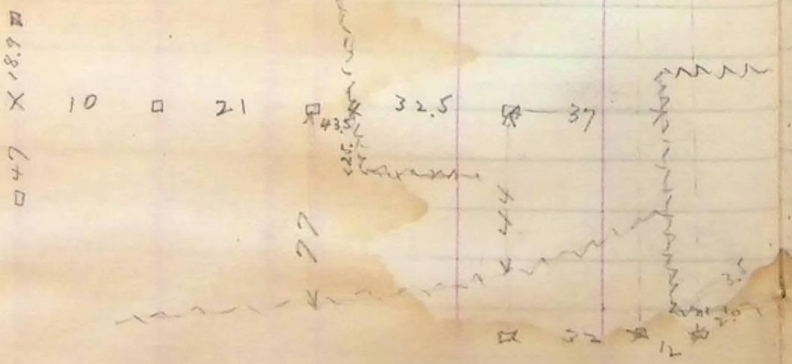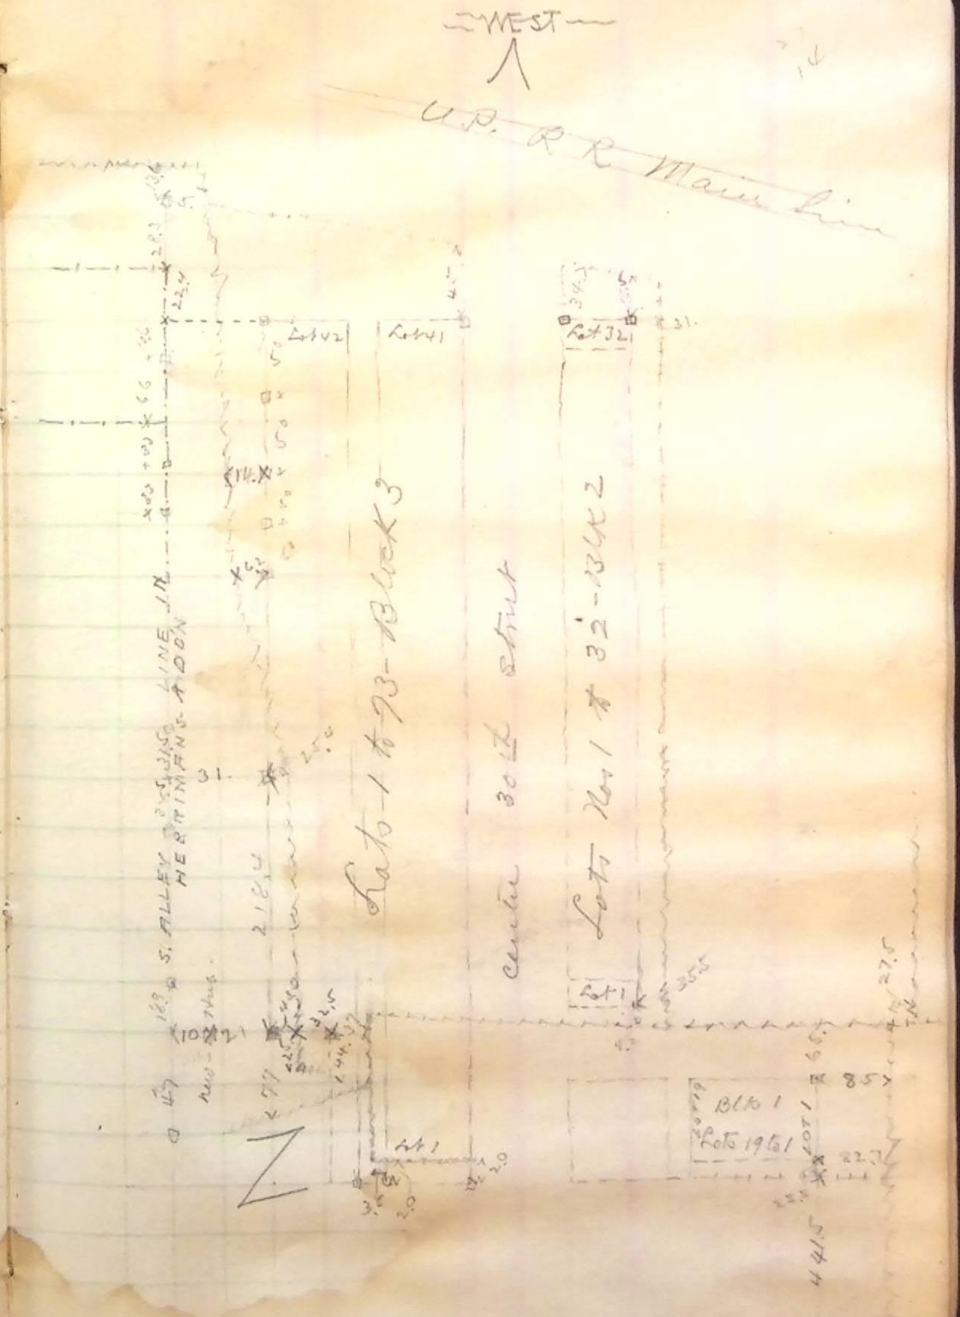
Enlarged Sketch of Z