

Survey to locate Electric
of Madison Avenue

Height Poles on West Side
Between 215 + 28th St
Oct 25th 1894


135

134

133

132

131

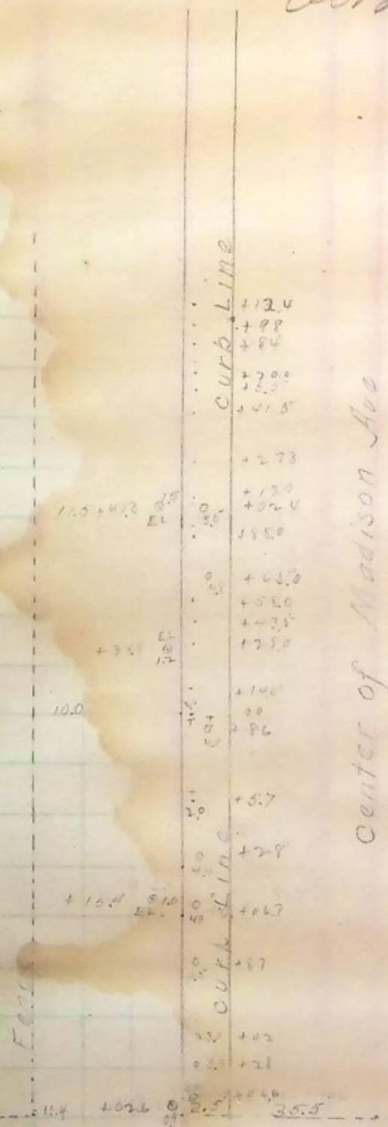

Center of Madison Ave