Location of Electric Light Poles West side Madison Avenue
between 211th St & 212th St.
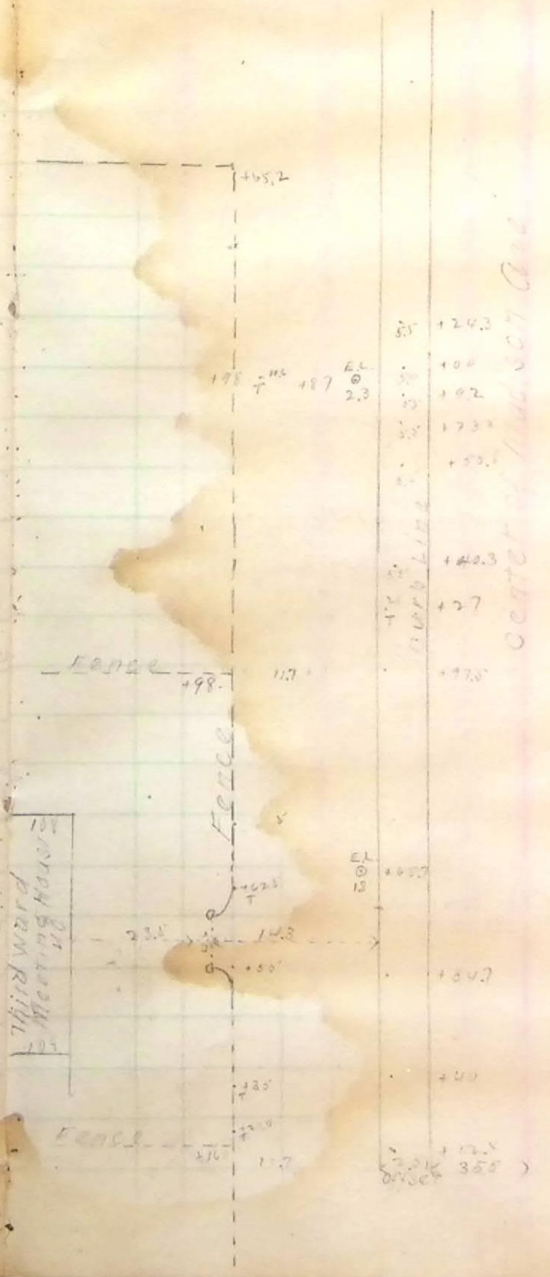
Oct 28th 1897