Sketch of first 18 blocks of Ogden City Cemetery annex showing location of monument.

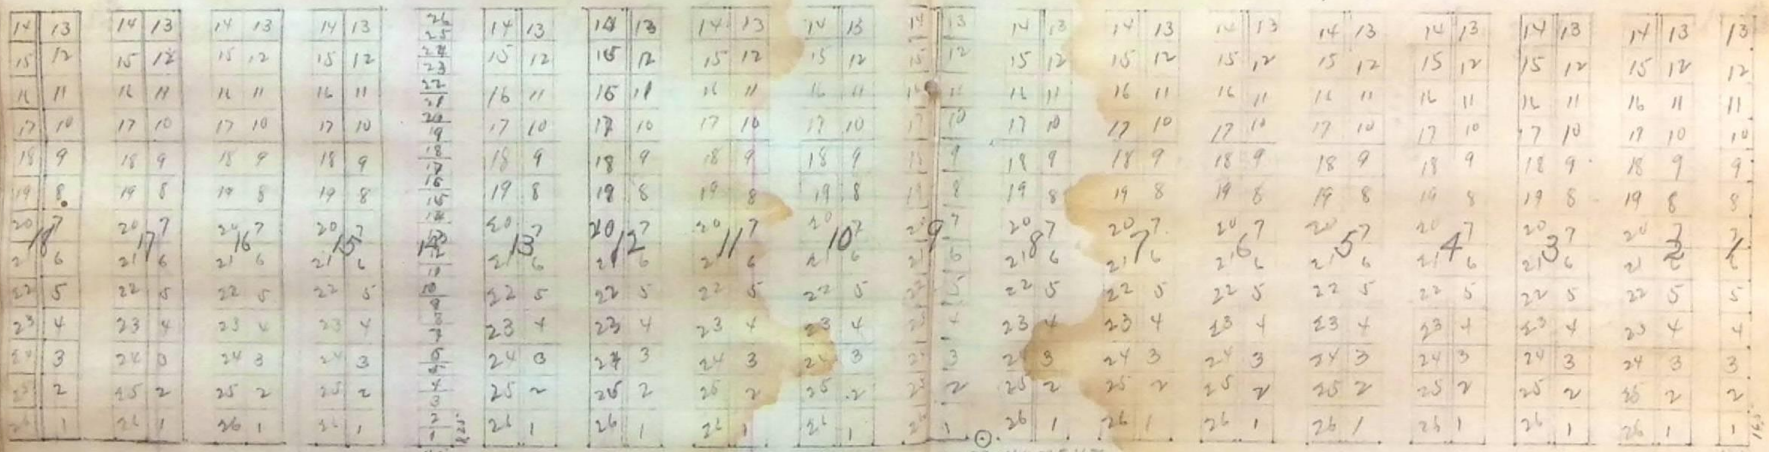

Set monument on south line half way between Block 8 & Block 9